

MISSISSIPPI DEPARTMENT OF NATURAL RESOURCES
 Bureau of Land and Water Resources
 Southport Mall
 P.O. Box 10631
 Jackson, Mississippi 39209
WATER WELL DRILLERS LOG

CODED

LEFLORE
M 64

~~J.K. K...~~ 19 86 J & K ILLI'S ATIA LeFlore
 date well completed firm name county well located

LANDOWNER: Robert Morton

description of formations encountered from to

(mailing address)

CLAY 0 23

WELL LOCATION:
 sec 35 T. 18 (N) R. 2 (E)
3 miles S.E. of Morgan City
 (distance) (direction) (nearest town)

FINE SAND 23-41

SAND GRAVEL 41-110

WELL PURPOSE:
 (home, irrigation, municipal, industrial)

WELL COMPLETION DATA:

- (1) diameter (inches) 10"
- (2) total depth (feet) 110'
- (3) static water level (feet) 25 below above top of ground.
- (4) casing PVC 70
 (material) (depth)
- 10 if telescope see back.
 (size)
- (5) screen 40 70
 (length) (depth to top)
- 10 PVC
 (size) (material)
- (6) pump 15 900
 (HP) (yield gpm)
- Electric
 (type power)
- (7) electric log NO
 (yes or no)

CODED

RECEIVED
 RECEIVED
 MAY 27 1980

(organization running log)


Department of Natural Resources
 Bureau of Land & Water Resources

(8) how well bottom plugged PLATE

DRILLERS REMARKS:

If well telescopes please sketch and show depths.

GROUND LEVEL

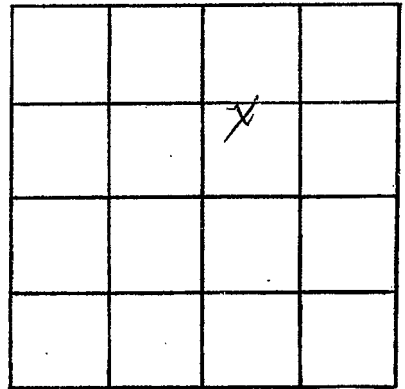

SECTION 35

Please indicate well location X.

ADDITIONAL INFORMATION

If more than one screen,
show locations of each on sketch.