

MISSISSIPPI DEPARTMENT OF NATURAL RESOURCES

Bureau of Land and Water Resources

Southport Mall

P.O. Box 10631

Jackson, Mississippi 39209

WATER WELL DRILLERS LOG

CODED

LEFFLORE
M 65
86 303KSE-01

3-10 1987 date well completed
Dyer Well Co. firm name
Lefflore county well located

LANDOWNER: Greenlake Farms Derwood Strain 102 1/2 Duval St Greenwood MS (mailing address)	Description of formations encountered	from	to
	Clay Sand & Gravel	0	40
		40	110
<p>WELL LOCATION: sec. 2 T 18 N S R 2 E W miles (distance) of Mansfield (direction) (nearest town)</p>			
<p>WELL PURPOSE: Irrigation (home, irrigation, municipal, industrial)</p>			
<p>WELL COMPLETION DATA:</p>			
(1) diameter (inches) 16"			
(2) total depth (feet) 110'			
(3) static water level (feet) _____ below/above top of ground.			
(4) casing STEEL (material), _____ (depth), 16" (size) if telescope see back.			
(5) screen 40' (length), _____ (depth to top), 16" (size), Med steel (material)			
(6) pump 30 (HP), 1500 (yield gpm) (type power)			
(7) electric log No (yes or no) (organization running log)			
(8) how well bottom plugged Plate			

CODED

RECEIVED

MAR 18 1987


Department of Natural Resources
Bureau of Land & Water Resources

DRILLERS REMARKS:

86-303KSE-01

If well telescopes please
sketch and show depths.

GROUND LEVEL

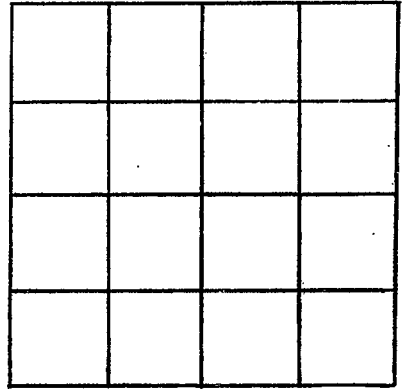

SECTION _____

Please indicate well location X.

ADDITIONAL INFORMATION

If more than one screen,
show locations of each on sketch.