

22-4195

MISSISSIPPI DEPARTMENT OF NATURAL RESOURCES

Bureau of Land and Water Resources

COUNTY WELL LOCATED
Leflore
 WELL NUMBER **M 166** CODED
 DATE WELL COMPLETED
5-26-89

PERMIT NUMBER
02908
 NAME OF DRILLING FIRM
Layne-Central Co.
Cleveland, MS

P.O. Box 10631
 Jackson, Mississippi 39209
 WATER WELL DRILLERS LOG

NAME & MAILING ADDRESS OF LANDOWNER
Town of Morgan City
P.O. Box 212
Morgan City, MS 38916
 WELL LOCATION: SEC **36** TOWNSHIP **18** RANGE **N 2 W**
 DISTANCE **inside city limits** DIRECTION _____ NEAREST TOWN _____
 OTHER LANDMARK _____
 WELL PURPOSE: Home, Irrigation, Municipal, Industrial, Fish Pond, etc.

PUMP DATA
 PUMP TYPE (Circle One): Submersible, Turbine Jet _____ Flowing Well, Other (Describe) _____
 POWER TYPE (Circle One): Electric Tractor, Diesel, Gasoline, Butane, Other (Describe) _____ H/P _____
 Pump Capacity (GPM) **150** No. of Stages **8** Setting Depth **80** FT.
 PUMP TEST
 Well yielded **150** GPM with a drawdown of **6** ft. after **24** hours of pumping

WELL DATA
 Well Depth **1252'** Casing Diameter (In.) **8** Casing Length (Ft.) **1207**
 Type of Casing **Steel** Hole Depth **1252'** Depth to Static Water Level **+8**
 TYPE OF COMPLETION: (Circle One or More): Gravel Packed, Underreamed, Telescoped, Natural Development, Open Hole, Other (Describe) _____
 Top of Lap Pipe or Reduction in Casing **1134 FEET** IF TELESCOPED OR MORE THAN ONE SCREEN: USE BACK PAGE

LOG DATA
 TYPE OF LOG RUN (Circle One): No Log Run, Electric Gamma Ray, Density, Sonic, Neutron, Other (Describe) _____
 Name of Organization Running Log
Layne

SCREEN DATA
 Diameter - Inches **4** Length - Feet **40** Slot Size - Inches **.020**
 Screen Type **st at Red Base** Depth to Bottom - Feet **1248**

GEOLOGIC DATA (Office Use Only)

Surface Elev.	Geologic Unit	Unit Thickness	Depth to Top
Subs. SWL	Date	Analysis	Aquifer Test


 Driller's Remarks **RECEIVED**
APR 12 1990
 Department of Natural Resources
 Bureau of Land & Water Resources

DESCRIPTION OF FORMATIONS ENCOUNTERED	FROM	TO	FORMATIONS (Continued)	FROM	TO
Clay	0	37	Sand & Clay	409	486
Sand	37	45	Sandy Shale	486	547
Coarse Sand	45	62	Clay	547	687
C. SAND & GRAVEL	62	90	Rock	687	688
Sand & gravel	90	145	Clay	688	715
Clay	145	153	Rock	715	717
Sand	153	185	Sandy Shale	717	726
Sandy Clay	185	215	Fine Sand & Shale	726	786
Clay	215	357	STRs. OF Sand & Shale	786	814
Sand & Clay	357	370	Rock	814	817
Sand	370	409	IF MORE SPACE IS NEEDED, USE BACK		

If well telescopes please sketch and show depths.

GROUND LEVEL

M-66

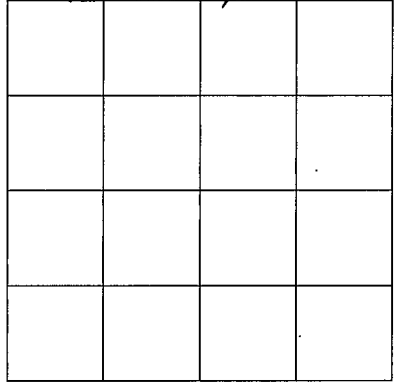

SECTION _____

Please indicate well location X.

ADDITIONAL INFORMATION

Shale	817 - 820
Rock	820 - 821
F. Sandy Shale	821 - 847
Sandy Shale	847 - 908
Shale	908 - 1000
STKs. of Fine Sand w/shale	1000 - 1017
Rock	1017 - 1018
STKs. of Fine Sand w/clay	1018 - 1120
SAND w/STKs. of shale	1120 - 1156
CLAY	1156 - 1186
SAND	1186 - 1260

If more than one screen,
show location of each on sketch.