

**MISSISSIPPI DEPARTMENT OF NATURAL RESOURCES**

Bureau of Land and Water Resources

COUNTY WELL LOCATED

*Leflore*

*148 A 013*

WELL NUMBER

CODED

PERMIT NUMBER

*MS-GW-09800*

NAME OF DRILLING FIRM

*Dynar Well*

**CODED**

P.O. Box 10631

Jackson, Mississippi 39209

WATER WELL DRILLERS LOG

DATE WELL COMPLETED

*11-9-89*

NAME & MAILING ADDRESS OF LANDOWNER

*Ridge Crest PLT*

*P.O. Box*

*Morgan City, Ms.*

WELL LOCATION:

SEC

TOWNSHIP

RANGE

*22*

*18*

*(N)*

*2*

*(E)*

DISTANCE

DIRECTION

NEAREST TOWN

Miles

of

OTHER LANDMARK

WELL PURPOSE: Home, Irrigation, Municipal, Industrial, ~~Fish Pond, Etc.~~

**PUMP DATA**

PUMP TYPE (Circle One):

Submersible, Turbine, Jet, Flowing Well,  
Other (Describe) \_\_\_\_\_

POWER TYPE (Circle One):

Electric, Tractor, Diesel, Gasoline, Butane,  
Other (Describe) \_\_\_\_\_ H/P \_\_\_\_\_

Pump Capacity (GPM)

No. of Stages

Setting Depth

*2000*

*2*

*60*

FT.

PUMP TEST

Well yielded \_\_\_\_\_ GPM with

a drawdown of \_\_\_\_\_ ft.

after \_\_\_\_\_ hours of pumping

**WELL DATA**

Well Depth

*104*

Casing Diameter (In.)

*16"*

Casing Length (Ft.)

*64'*

Type of Casing

*steel*

Hole Depth

Depth to Static Water Level

TYPE OF COMPLETION: (Circle One or More):

Gravel Packed, Underreamed, Telescoped,  
Natural Development, Open Hole, Other  
(Describe) \_\_\_\_\_

Top of Lap Pipe or Reduction in Casing

FEET

IF TELESCOPED OR MORE THAN ONE SCREEN: USE BACK PAGE

**SCREEN DATA**

Diameter - Inches

*16"*

Length - Feet

*40'*

Slot Size - Inches

*.030*

Screen Type

*Wire Wrap*

Depth to Bottom - Feet

**LOG DATA**

TYPE OF LOG RUN (Circle One):

Electric, Gamma Ray, Density, Sonic, Neutron,  
Other (Describe) \_\_\_\_\_

No Log Run

Name of Organization Running Log

*None*

**GEOLOGIC DATA (Office Use Only)**

Surface Elev.	Geologic Unit	Unit Thickness	Depth to Top
Subs. SWL	Date	Analysis	Aquifer Test

Driller's Remarks

DESCRIPTION OF FORMATIONS ENCOUNTERED	FROM	TO
<i>Clay</i>	<i>0</i>	<i>38</i>
<i>Fine Sand</i>	<i>38</i>	<i>50</i>
<i>Fine Sand + Gravel</i>	<i>50</i>	<i>56</i>
<i>M. Sand + Gravel</i>	<i>56</i>	<i>70</i>
<i>Fine Sand + Gravel</i>	<i>70</i>	<i>85</i>
<i>M. Sand + Gravel</i>	<i>85</i>	<i>90</i>
<i>Sand + Gravel</i>	<i>90</i>	<i>104</i>

FORMATIONS (Continued) FROM TO

**PRELIMINARY**

*NOV 14 1989*

Department of Natural Resources  
Bureau of Land & Water Resources


IF MORE SPACE IS NEEDED, USE BACK

If well telescopes please  
sketch and show depths.

---

GROUND LEVEL

---

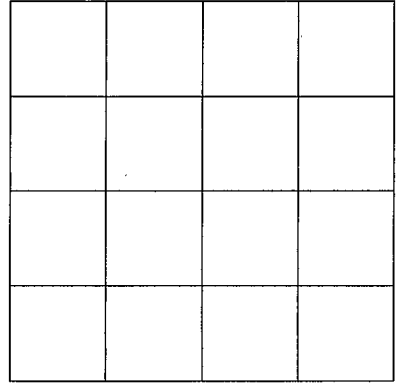

SECTION \_\_\_\_\_

Please indicate well location X.

---

---

ADDITIONAL INFORMATION

If more than one screen,  
show location of each on sketch.

---