

State Well Report

Part 1

Mississippi Department of Environmental Quality
Office of Land and Water Resources
P.O. Box 10631
Jackson, MS 39289-0631
(601)961-5210
(601)354-6938 (fax)

County: Leflore
Permit #: EW42390
Irrigation Equipment
Driller:
Date drilling completed: 3-26-08

For Office Use Only:
Aquifer: _____
Well #: M-117
L. S. Elevation: _____
E-log #: _____

State Law requires that this report be prepared by the driller in detail and filed with the Department within 30 days of completion of drilling of the well.

Well Owner Information	Well Location
Owner Name: <u>Morgan Fish Farm</u>	Latitude: <u>33° 22' 53.3"</u> Longitude: <u>90° 22' 05.3"</u>
Mailing Address: <u>P.O. Box 174</u>	Method of Lat/Long (circle one): <u>Conventional Survey</u>
<u>Morgan City</u> Ms. <u>38946</u>	USGS quad, Hand-held GPS, Survey-grade GPS
City State Zip Code	<u>NE 1/4 SE 1/4</u> Sec <u>35</u> Twn <u>18N</u> Rng <u>2W</u>
Telephone No. <u>(662) 254-9347</u>	Distance Direction Nearest Town <u>1</u> Miles <u>West</u> of <u>Morgan City</u>

Well Data

Purpose of Well (circle one) Home Industrial Public Supply Irrigation Fish Culture Other: _____

Date well drilling started: 3-26-08 Date well drilling completed: 3-26-08

If flowing, method of flow regulation: Valve _____ Other (describe) _____

Static Water Level: 3' feet above or below (circle one) land surface Date measured: 3-28-08

Method of Measurement (circle one) steel tape electric tape air line other: _____

Hole depth: 121 Well depth: 121 Well grouted to a depth of 10 feet

Type of grout (circle one): Cement Bentonite Mix

Casing length: 81 feet Casing diameter: 16 inches Type of casing: PVC

Screen length: 40 feet Screen diameter: 16 inches Type of screen: PVC

Screen slot size: .050 inches Setting depth: From 82 feet to 121 feet

Type of completion (circle all applicable): Gravel packed Underreamed Telescoped Open hole Natural Development

Other (describe): _____

Top of lap pipe or reduction in casing: _____ feet. If telescoped or more than one screen, describe on back of page

Logs run (circle all applicable): No log run Electric Gamma Ray Density Sonic Neutron Other: _____

Name of organization running log(s): _____

I certify that the well was drilled, constructed, and completed in accordance with all applicable requirements of the Mississippi Department of Environmental Quality and/or the Mississippi Department of Health regulations and state laws.

Irrigation Equipment Inc
Patrick M. Chism 0695

Print Name of Water Well Contractor and License No. _____ Signature of Water Well Contractor Pat

RECEIVED
MAR 31 2008
BY: OLWR

61042390

M-117

If well telescopes please sketch below and show depths.


Ground Level

Description of Formations Encountered	From	To
Clay	0	27
Fine Sand	28	38
Fine Sand + Gravel	39	51
Medium Sand + Gravel	52	118
Clay	119	121

If more than one screen, show location of each on sketch

Sketch the property layout and include the following: 1) the well location; 2) any permanent structures on the property that may aid in locating the well; 3) any roads, power lines, or other items that may aid in locating the property and the well; 4) indicate direction.

Landowner Name: Morgan Fish Farm

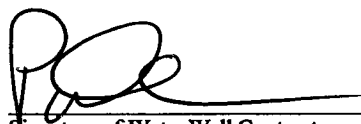

 Signature of Water Well Contractor

RECEIVED
 MAR 31 2008
 BY: OLWR

STATE WELL REPORT

Part 2

Pump Installer's Completion Report
 Mississippi Department of Environmental Quality
 Office of Land and Water Resources
 P.O. Box 10631
 Jackson, MS 39289-0631
 (601) 961-5210
 (601) 354-6938 (fax)

County: Leflore
 Permit #: 6642390
 Irrigation Equipment
 Driller: _____
 Date completed: 3-26-08

For Office Use Only:

Aquifer: _____
 Well #: M-117
 Elevation: _____

This report should be prepared by the pump installer in detail and filed with the Department within 30 days of the installation of pump.


Well Owner Information	Well Location
Owner Name: <u>Morgan Fish Farm</u> Mailing Address: <u>P.O. Box 174</u> <u>Morgan City Ms. 38946</u> <small>City State Zip Code</small> Telephone No. <u>(662) 254-9347</u>	Latitude: _____ Longitude: _____ Method of Lat/Long (circle one): Conventional Survey, USGS quad, Hand-held GPS, Survey-grade GPS <u>NE 1/4 SE 1/4 Sec 35 Twn 18N Rng 2W</u> Distance Direction Nearest Town <u>1 Miles West of Morgan City</u>

Pump Type Circle one	Power Type Circle one
Air Lift Jet <input checked="" type="radio"/> <u>Submersible</u> Bucket Piston Turbine Centrifugal Rotary Flowing Well Other (specify): _____ Date Pump Installed: <u>3-26-08</u> Rated Pump Capacity: <u>750 ±</u> Gallons Per Minute	Diesel Engine Gasoline Engine Natural Gas <input checked="" type="radio"/> <u>Electric Motor</u> Hand Tractor PTO Windmill Other (specify): _____ Horse Power Rating of Motor: _____ <u>15</u> Setting Depth: <u>70</u> feet Number of Stages: <u>1</u>

Pump Test Data	Method of Measuring Water Level Circle one
Date Well Tested: _____ Static Water Level (A): _____ Feet Below Land Surface Pumping Water Level (B): _____ Feet Below Land Surface Drawdown [(B) - (A)]: _____ Feet Below Land Surface Test Pumping Rate: _____ Gallons Per Minute Duration of Pump Test (minimum 4 hours): _____ hours	Air Line Electric Measuring Line Steel Tape Other (specify): _____ For flowing well, measured shut in head: _____ feet Well yielded _____ GPM with a drawdown of _____ feet after _____ hours of pumping

I HEREBY CERTIFY that the above statements are true to the best of my knowledge.

Patrick M. Chism 0695
 Print Name of Pump Installer and License No. (if applicable)

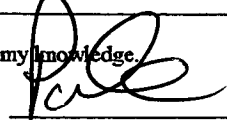
 Signature of Pump Installer





RECEIVED
 MAR 31 2008
 BY: OLWR

66-112390

M-117

5

Morgan Fish Farm Map

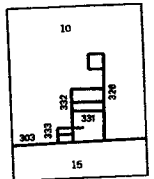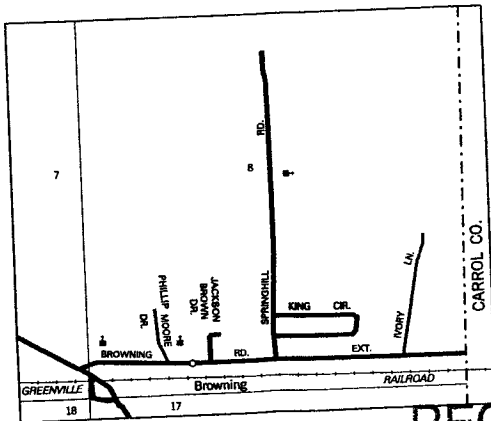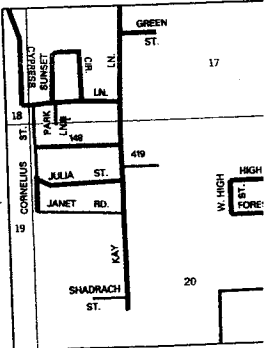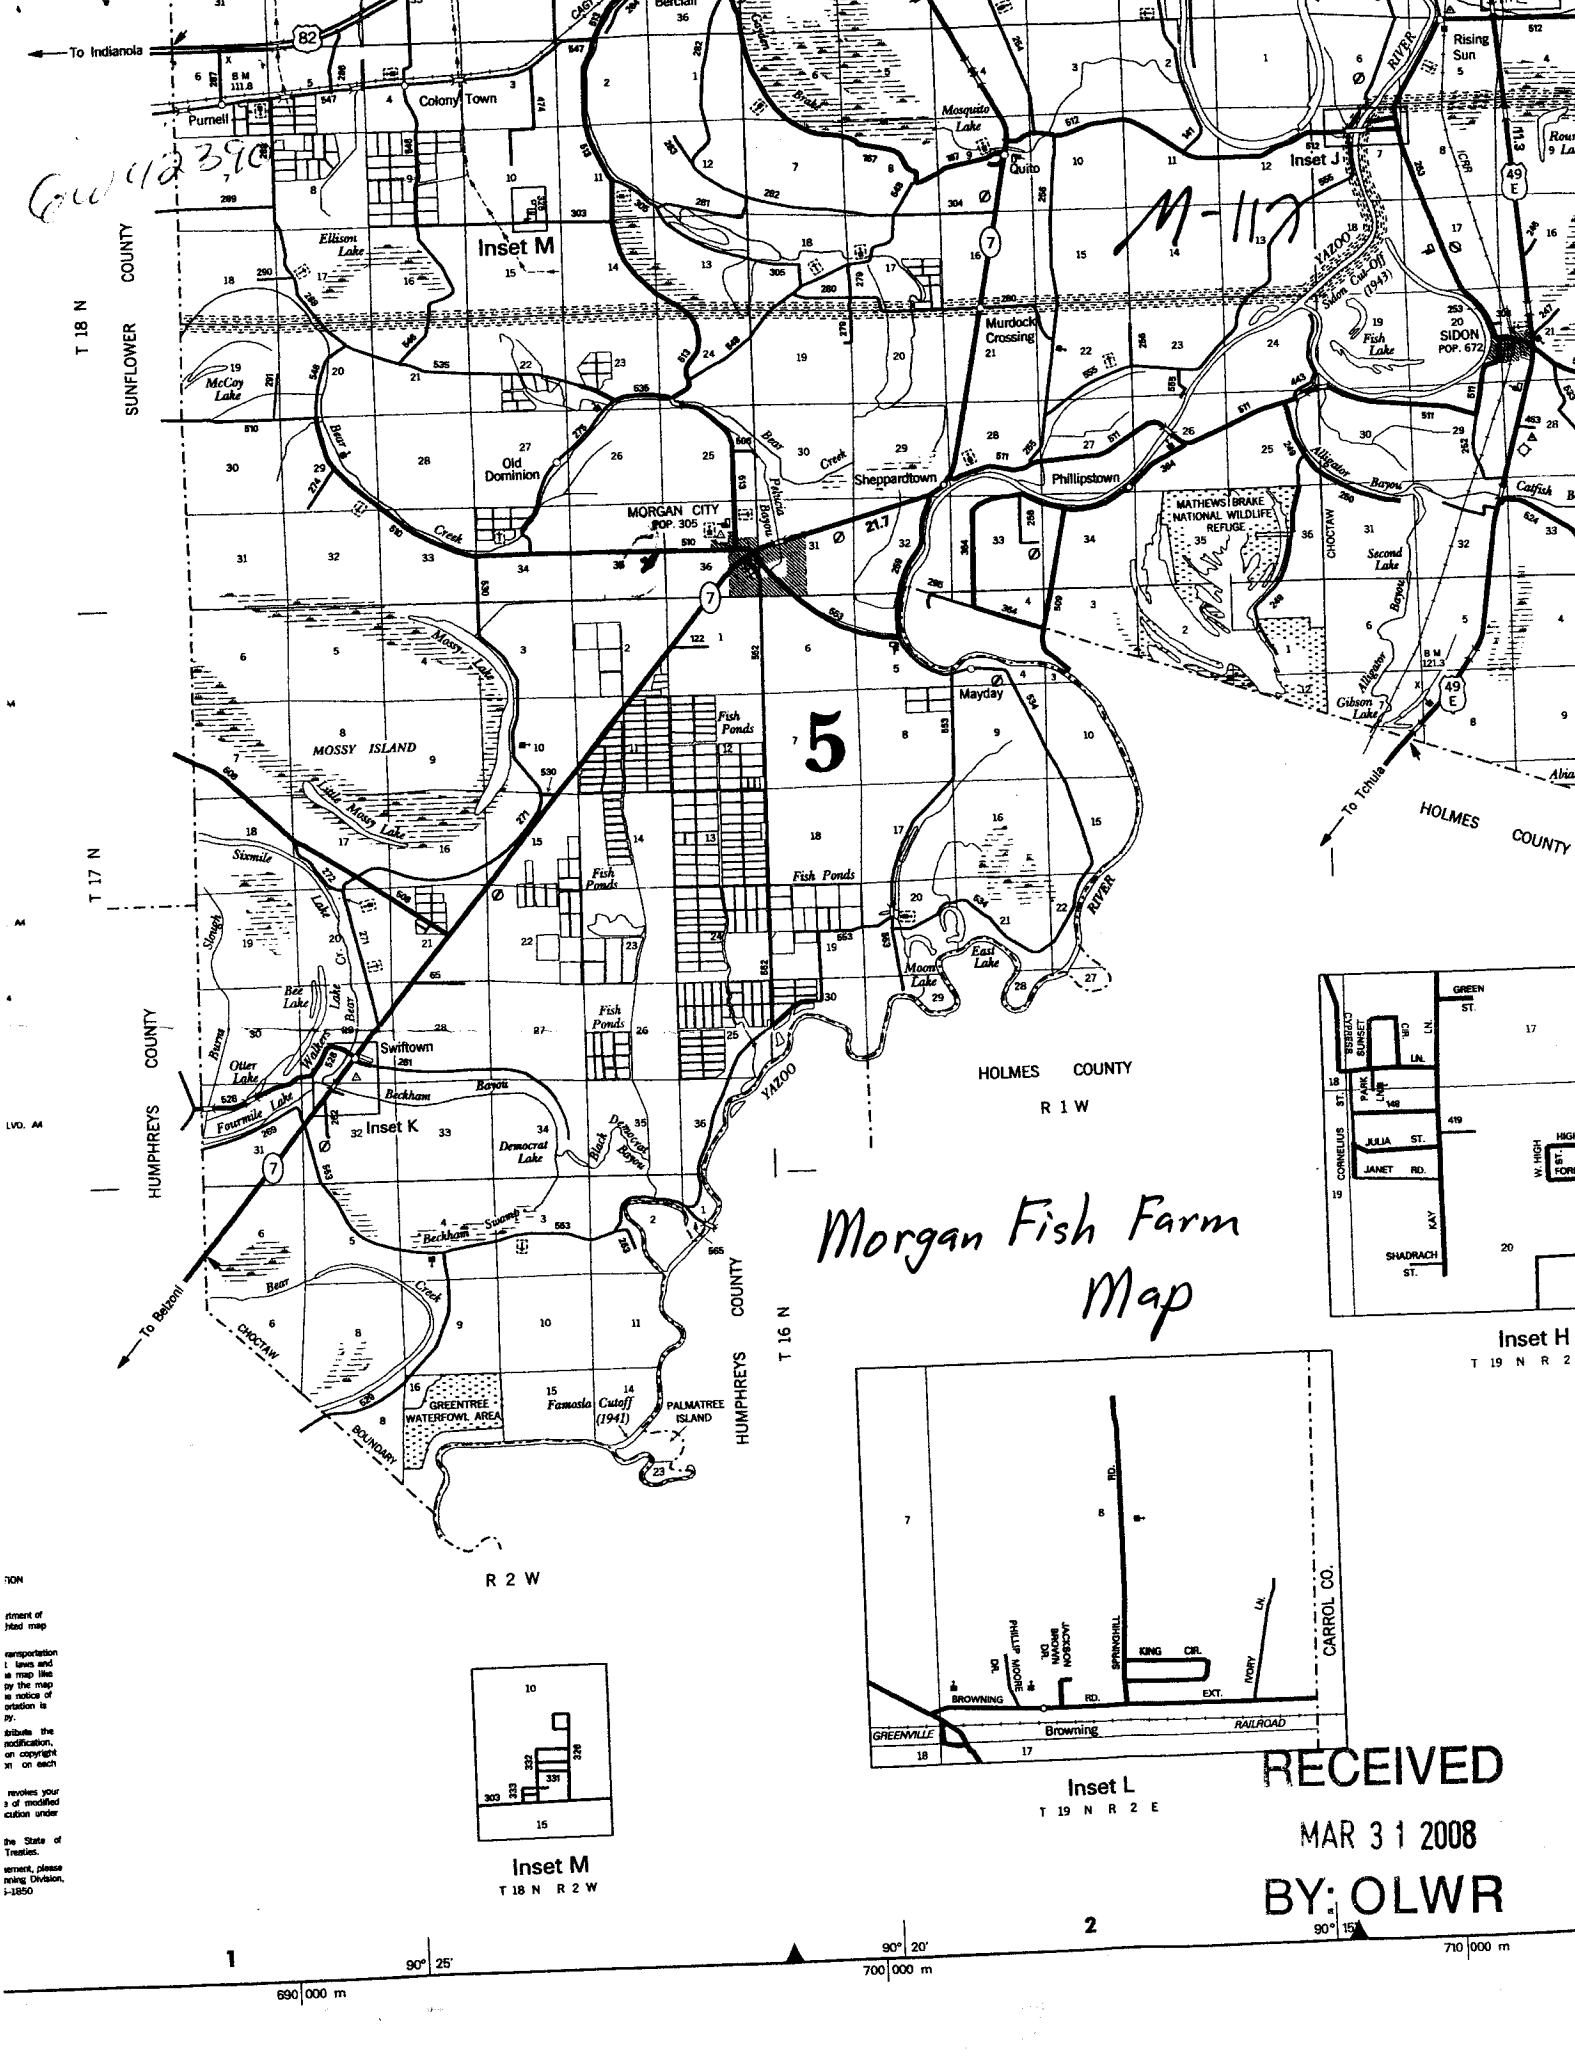

10N
 extent of
 head map
 transportation
 1: lines and
 a map lines
 by the map
 is notice of
 oration is
 by.
 include the
 modification,
 on copyright
 at on each
 involves your
 s of modified
 cution under
 the State of
 Treaties.
 vernent, please
 rning Division,
 1-1850

RECEIVED
 MAR 31 2008
 BY OLWR