

Leflore
M 100
4-66

MISSISSIPPI BOARD OF WATER COMMISSIONERS

WATER WELL DRILLERS LOG


Date: 4-5-, 1966, Driller: Butane Gas Co. of Greenwood County Leflore
(Name)

	Description & Color of Materials Sand, Clay, Red Clay, Shell, etc.	Thick- ness Feet	Depth Feet
(1) Owner of Land: <u>E. D. Strain, Jr.</u> (Name)	<u>Clay</u>	<u>13</u>	<u>13</u>
<u>Morgan City, Miss.</u> (Address)	<u>Blue Clay</u>	<u>10</u>	<u>23</u>
(2) Location: <u>1/4</u> , <u>1/4</u> , Sec. <u>T</u> <u>R</u>	<u>Blue Clay</u>	<u>10</u>	<u>33</u>
<u>5</u> miles <u>West</u> of <u>Morgan City</u> (distance) (direction) (Nearest Town)	<u>Coarse Sand</u>	<u>10</u>	<u>43</u>
(3) Topography: <u>Flat</u> (Hilly) (Flat) (Level)	<u>Coarse Sand</u>	<u>10</u>	<u>53</u>
(4) Purpose of Well: <u>Irrigation</u> (Domestic Irrigation Municipal, Industrial, Other)	<u>Coarse Sand</u>	<u>10</u>	<u>63</u>
	<u>Sand and Gravel</u>	<u>10</u>	<u>73</u>
	<u>Sand and Gravel</u>	<u>10</u>	<u>83</u>
	<u>Sand and Gravel</u>	<u>10</u>	<u>93</u>
	<u>Sand and Gravel</u>	<u>10</u>	<u>103</u>

Information upon completion of well:

- (1) Diameter 16 inches.
- (2) Total Depth 98 feet.
- (3) Water Level 8 feet below top of ground.
- (4) Cased to 58, Size 16
- (5) Screen: Size 16, Length 40
- (6) Were any formations sealed against pollution?
no yes, X no.

If YES depth of formation _____
Why _____
Drillers Remarks: _____

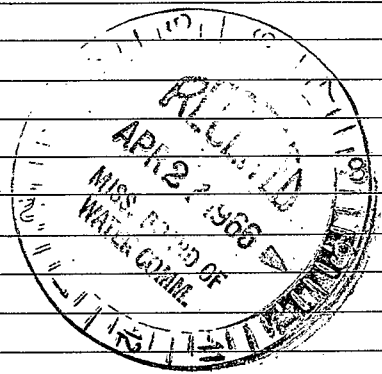

(Use Back Side)

Well No.

