

Before MISSISSIPPI BOARD OF WATER COMMISSIONERS

M ~~100~~ -1002
3-31-66

WATER WELL DRILLERS LOG

~~54~~ 54
LET FLORE
~~Washington~~

Date: 3/31, 1966, Driller: Bailey Drly Co County: ~~Washington~~

(1) Owner of Land	Description & Color of Materials <small>Sand, Silt, Red Clay, Shell, etc.</small>	Thick-ness Feet	Depth Feet
Morgan City Comm. (Name) Morgan City, Miss. (Address)	Clay		65
Location: 1/4, 1/4, Sec. 3118NW, T, R	Sand		70
at Morgan City (distance) miles, (direction) of, (Nearest Town)	Gravel		140
(3) Topography: Flat (Hilly) (Flat) (Level)	Mud		185
(4) Purpose of Well: Domestic (Domestic Irrigation Municipal, Industrial, Other)	Sand		220
	Mud		380
	Sand		460
	Mud + rocks		960
	Mud + sand		980
	Mud		1020
	Mud + sand		1069
	Mud		1099
	Mud + sand		1129
	Mud		1164
	Sand		1206

Information upon completion of well:


- (1) Diameter 6" inches.
- (2) Total Depth 1206 feet.
- (3) Water Level 42 feet above below top of ground.
- (4) Cased to all way, size 6"
- (5) Screen: Size 4", Length 40 ft.
- (6) Were any formations sealed against pollution?

yes, no.

If YES depth of formation _____

Why _____

Drillers Remarks: _____

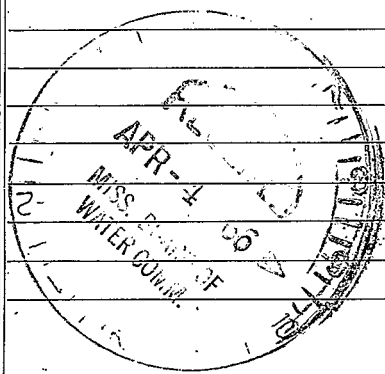

1206
40
1166

236

(Use Back Side)

Well No.

