

Leflore
 No 202
 2-18-76

MISSISSIPPI
 BOARD OF WATER COMMISSIONERS
 416 North State Street
 Jackson, Mississippi 39201

WATER WELL DRILLERS LOG

2-18-76
 date well completed

15H BUTANE GAS CO. OF GREENWOOD
 firm name

Leflore
 county well located

| LANDOWNER: | description of formations encountered | from | to |
|---|---------------------------------------|------|-----|
| W. D. Adams | | | |
| Moorhead (mailing address) | Clay | 0 | 10 |
| | SAND & Clay | 10 | 80 |
| | SAND + GRAVEL | 80 | 140 |
| WELL LOCATION: | Clay | 140 | 180 |
| sec. 7 T. 18 N. R. 2 W. | SHALE | 180 | 200 |
| 2 miles SW of Colony Town | SAND | 200 | 270 |
| (distance) (direction) (nearest town) | Clay | 270 | 380 |
| | SAND | 380 | 419 |
| WELL PURPOSE: Home (home, irrigation, municipal, industrial) | | | |
| WELL COMPLETION DATA: | | | |
| (1) diameter (inches) 4 x 2 | | | |
| (2) total depth (feet) 419 | | | |
| (3) static water level (feet) 17 below top of ground. | | | |
| (4) casing Steel 399 (material) (depth) | | | |
| 4 x 2 If telescope see back. (size) | | | |
| (5) screen 20 399 (length) (depth to top) | | | |
| 2" Stair treads (size) (material) | | | |
| (6) pump 1/2 10 (HP) (yield gpm) | | | |
| Elec (type power) | | | |
| (7) electric log NO (yes or no) | | | |
| (organization running log) | | | |
| (8) how well bottom plugged Back Pressure Valve | | | |
| DRILLERS REMARKS: | | | |

RECEIVED

FEB 23 1976


If well telescopes please sketch and show depths.

GROUND LEVEL

105' - 4" CASING →

294' - 2" CASING →

20' - 2" SCREEN →

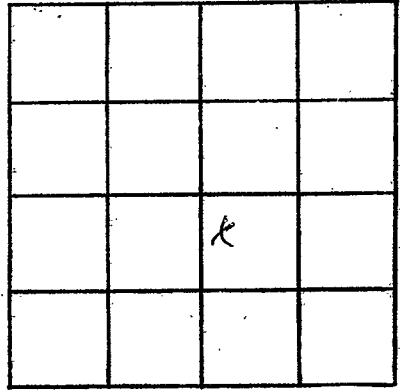

SECTION 7

Please indicate well location X.

ADDITIONAL INFORMATION

If more than one screen, show locations of each on sketch.