

1

MISSISSIPPI DEPARTMENT OF NATURAL RESOURCES

Bureau of Land and Water Resources

P.O. Box 10631
Jackson, Mississippi 39209
WATER WELL DRILLERS LOG

COUNTY WELL LOCATED <i>LeFlore</i>	
WELL NUMBER <i>M</i>	CODED
<i>2008</i>	
DATE WELL COMPLETED <i>9-2</i>	

PERMIT NUMBER
NAME OF DRILLING FIRM <i>J. B. K. IRRIG'S ATCO</i>
<i>Well Set</i>

NAME & MAILING ADDRESS OF LANDOWNER <i>Panther Run</i>
<i>P.O. Box 646</i>
<i>MOOREHEAD, MS. 38761</i>
WELL LOCATION: SEC <i>6</i> TOWNSHIP <i>18 N</i> RANGE <i>2 E</i>
DISTANCE <i>3</i> Miles DIRECTION <i>N.E.</i> of NEAREST TOWN <i>MOOREHEAD</i>
OTHER LANDMARK
WELL PURPOSE: Home, Irrigation, Municipal, Industrial, Fish Pond, etc. <i>Fish Ponds</i>

PUMP DATA
PUMP TYPE (Circle One): Submersible, <u>Turbine</u> , Jet, Flowing Well, Other (Describe) _____
POWER TYPE (Circle One): <u>Electric</u> , Tractor, Diesel, Gasoline, Butane, Other (Describe) _____
Pump Capacity (GPM) <i>2400</i> No. of Stages <i>2</i> Setting Depth <i>60</i> FT.
PUMP TEST
Well yielded <i>2400</i> GPM with a drawdown of _____ ft. after _____ hours of pumping

WELL DATA
Well Depth <i>119</i> Casing Diameter (In.) <i>16</i> Casing Length (Ft.) <i>79</i>
Type of Casing <i>Steel</i> Hole Depth <i>119</i> Depth to Static Water Level <i>28</i>
TYPE OF COMPLETION: (Circle One or More): <u>Gravel Packed</u> , Underreamed, Telescoped, Natural Development, Open Hole, Other
Top of Lap Pipe or Reduction in Casing FEET IF TELESKOPED OR MORE THAN ONE SCREEN: USE BACK PAGE

LOG DATA
TYPE OF LOG RUN (Circle One): No Log Run, Electric, Gamma Ray, Density, Sonic, Neutron, Other (Describe) _____
Name of Organization Running Log

SCREEN DATA
Diameter - Inches <i>16</i> Length - Feet <i>40</i> Slot Size - Inches <i>.030</i>
Screen Type <i>Steel</i> Depth to Bottom - Feet <i>119</i>

GEOLOGIC DATA (Office Use Only)
Surface Elev. Geologic Unit Unit Thickness Depth to Top
Subs. SWL Date Analysis Aquifer Test


DESCRIPTION OF FORMATIONS ENCOUNTERED	FROM	TO
<i>TOP SOIL 6cm</i>	<i>0</i>	<i>21</i>
<i>FINE SAND</i>	<i>21</i>	<i>47</i>
<i>COARSE SAND</i>	<i>47</i>	<i>61</i>
<i>SAND & GRAVEL</i>	<i>61</i>	<i>119</i>

Driller's Remarks

FORMATIONS TO CONTINUE FROM TO		
<i>DIPLOMA</i>	<i>61</i>	<i>119</i>
<i>OCT 08 1990</i>		
Department of Natural Resources Bureau of Land & Water Resources		
IF MORE SPACE IS NEEDED, USE BACK		

If well telescopes please sketch and show depths.

GROUND LEVEL

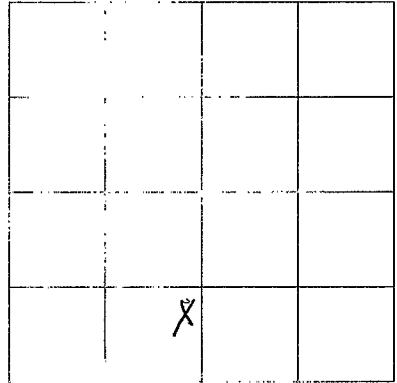

NO. 6

Location of well location X.

ADDITIONAL INFORMATION

Lined area for additional information.

If more than one screen, show location of each on sketch.