

# MISSISSIPPI DEPARTMENT OF NATURAL RESOURCES

Bureau of Land and Water Resources

P.O. Box 10631  
Jackson, Mississippi 39209  
WATER WELL DRILLERS LOG

COUNTY WELL LOCATED <b>LeFlore</b>	
WELL NUMBER <b>M</b>	CODED
2009	
DATE WELL COMPLETED <b>9-6-90</b>	

PERMIT NUMBER
NAME OF DRILLING FIRM <b>J B K Irrigation</b>
<b>well set.</b>

NAME & MAILING ADDRESS OF LANDOWNER <b>Parthet Row</b>		
<b>P.O. Box 646</b>		
<b>Moohthead, ms 38761</b>		
WELL LOCATION:	SEC	TOWNSHIP RANGE
	<b>8</b>	<b>18 N 2 W</b>
DISTANCE	DIRECTION	NEAREST TOWN
<b>3 1/2</b> Miles	<b>NE</b>	<b>Moohthead</b>
OTHER LANDMARK		
WELL PURPOSE: Home, Irrigation, Municipal, Industrial, Fish Pond, etc. <b>Fish Pond</b>		

PUMP DATA		
PUMP TYPE (Circle One): Submersible, <b>Turbine</b> , Jet, Flowing Well, Other (Describe) _____		
POWER TYPE (Circle One): <b>Electric</b> , Tractor, Diesel, Gasoline, Butane, Other (Describe) _____		
Pump Capacity (GPM)	No. of Stages	Setting Depth
<b>2400</b>	<b>2</b>	<b>60</b> FT.
PUMP TEST		
Well yielded <b>2400</b> GPM with a drawdown of _____ ft. after _____ hours of pumping		

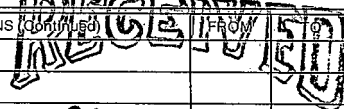
WELL DATA		
Well Depth <b>118</b>	Casing Diameter (In.) <b>16</b>	Casing Length (Ft.) <b>78</b>
Type of Casing <b>Steel</b>	Hole Depth <b>118</b>	Depth to Static Water Level <b>27</b>
TYPE OF COMPLETION: (Circle One or More): <b>Gravel Packed</b> , Underreamed, Telescoped, Natural Development, Open Hole, Other (Describe) _____		
Top of Lap Pipe or Reduction in Casing		
FEET	IF TELESCOPED OR MORE THAN ONE SCREEN: USE BACK PAGE	

LOG DATA	
TYPE OF LOG RUN (Circle One): Electric, Gamma Ray, Density, Sonic, <b>N6 Log Run</b> , Other (Describe) _____	
Name of Organization Running Log	

SCREEN DATA		
Diameter - Inches <b>16</b>	Length - Feet <b>40</b>	Slot Size - Inches <b>.030</b>
Screen Type <b>Steel</b>	Depth to Bottom - Feet <b>118</b>	

GEOLOGIC DATA (Office Use Only)			
Surface Elev.	Geologic Unit	Unit Thickness	Depth to Top
Subs. SWL	Date	Analysis	Aquifer Test
Driller's Remarks			

DESCRIPTION OF FORMATIONS ENCOUNTERED	FROM	TO
<b>TOP SOIL &amp; CLAY</b>	<b>0</b>	<b>23</b>
<b>FINE SAND</b>	<b>23</b>	<b>39</b>
<b>SAND</b>	<b>39</b>	<b>42</b>
<b>COARSE SAND &amp; GRAVEL</b>	<b>42</b>	<b>118</b>

 <b>OCT 08 1990</b> Department of Natural Resources Bureau of Land & Water Resources
IF MORE SPACE IS NEEDED, USE BACK

If well telescopes please  
sketch and show depths.

GROUND LEVEL

X			

SECTION 8

Please indicate well location X.

ADDITIONAL INFORMATION

If more than one screen,  
show location of each on sketch.