

**MISSISSIPPI DEPARTMENT OF ENVIRONMENTAL QUALITY**  
Office of Land and Water Resources

**RECEIVED**

COUNTY WELL LOCATED  
**Le Flore**

WELL NUMBER CODED  
**M 2024**

DATE WELL COMPLETED  
**9-24-99**

PERMIT NUMBER

NAME OF DRILLING FIRM  
**IRRIGATION EQUIPMENT**

**601/887-2555**  
**INDIANOLA, MS**

**PCT 26 1999** P. O. Box 10631  
Jackson, MS 39289-0631

Office of Environmental Quality  
**WATER WELL DRILLERS LOG**

NAME & MAILING ADDRESS OF LANDOWNER  
**P + T Farms**  
**c/o Tommy Andrus**  
**144 PARKER ROAD**  
**MOORHEAD, MS 38761**

WELL LOCATION. SEC TOWNSHIP RANGE  
**5 18 N 2 E W**

DISTANCE DIRECTION NEAREST TOWN  
**1** Miles **West** of **Colony Town**

OTHER LANDMARK

WELL PURPOSE: Home, Irrigation, Municipal, Industrial, Fish Pond, etc.  
**Irrigation**

**PUMP DATA**

PUMP TYPE (Circle One):  
Submersible, **Turbine**, Jet, Flowing Well,  
Other (Describe)

POWER TYPE (Circle One):  
Electric, Tractor, **Diesel**, Gasoline, Butane,  
Other (Describe) H/P **60**

Pump Capacity (GPM) No. of Stages Setting Depth  
**2500 1 70 FT.**

PUMP TEST

Well yielded \_\_\_\_\_ GPM with  
a drawdown of \_\_\_\_\_ ft.  
after \_\_\_\_\_ hours of pumping.

**WELL DATA**

Well Depth <b>117</b>	Casing Diameter (In.) <b>16</b>	Casing Length (Ft.) <b>77</b>
Type of Casing <b>PVC</b>	Hole Depth <b>117</b>	Depth to Static Water Level <b>38 Ft.</b>

TYPE OF COMPLETION: (Circle One or More):  
**Gravel Packed**, Underreamed, Telescoped,  
Natural Development, Open Hole, Other  
(Describe)

**LOG DATA**

TYPE OF LOG RUN (Circle One):  
No Log Run, Electric, Gamma Ray, Density, Sonic, Neutron,  
Other (Describe)

Name of Organization Running Log

WELL GROUTED TO A DEPTH OF \_\_\_\_\_ FEET  
Type Grout (circle one): Cement, Bentonite, or Mix

**GEOLOGIC DATA (Office Use Only)**

Surface Elev.	Geologic Unit	Unit Thickness	Depth to Top
Subs. SWL	Date	Analysis	Aquifer Test


**SCREEN DATA**

Diameter - inches <b>16</b>	Length - Feet <b>40</b>	Slot Size - inches <b>.050</b>
Screen Type <b>PVC</b>	Depth to Bottom - Feet <b>117</b>	

Driller's Remarks

DESCRIPTION OF FORMATIONS ENCOUNTERED	FROM	TO	FORMATIONS (Continued)	FROM	TO
<b>CLAY</b>	<b>0</b>	<b>31</b>			
<b>FINE SAND</b>	<b>31</b>	<b>42</b>			
<b>FINE SAND + GRAVEL</b>	<b>42</b>	<b>55</b>			
<b>med. SAND + GRAVEL</b>	<b>55</b>	<b>114</b>			
<b>CLAY</b>	<b>114</b>	<b>117</b>			

IF MORE SPACE IS NEEDED, USE BACK

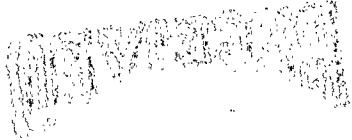

If well telescopes please sketch and show depths.

*Faint, illegible handwritten notes.*

GROUND LEVEL

Large vertical rectangular area for sketching well telescopes and depths.

	X		

SECTION 5

Please indicate well location X.

ADDITIONAL INFORMATION

Series of horizontal lines for providing additional information.

If more than one screen, show location of each on sketch.