

MISSISSIPPI DEPARTMENT OF NATURAL RESOURCES

Bureau of Land and Water Resources

Southport Mall.

P.O. Box 10631

Jackson, Mississippi 39209

WATER WELL DRILLERS LOG

CODED

Leflore
N
9-9-80

9/9 1980 DYER WELL + IRR. LEFLORE
 date well completed firm name county well located

LANDOWNER: BLACK BOTTOM FARMS
P.O. BOX 173
INVERNESS, MS 38753
 (mailing address)

description of formations encountered

from

to

CLAY 0 43
SAND & GRAVEL 43 106

WELL LOCATION:
13 sec. 2 T. 17 N. R. 1 E. S. 1
2 miles S of MORGAN CITY
 (distance) (direction) (nearest town)

WELL PURPOSE:
 (home, irrigation, municipal, industrial)

WELL COMPLETION DATA:

(1) diameter (inches) 16

(2) total depth (feet) 106

(3) static water level (feet) 18 below above top of ground.

(4) casing STEEL 66
 (material) (depth)

16 If telescope see back.
 (size)

(5) screen 40 66
 (length) (depth to top)

16 STEEL
 (size) (material)

(6) pump 60 2800
 (HP) (yield gpm)

DIESEL
 (type power)

(7) electric log NO
 (yes or no)

 (organization running log)


(8) how well bottom plugged STEEL PLATE

DRILLERS REMARKS:

DEPT. OF NATURAL RESOURCES
 BUREAU OF LAND & WATER RESOURCES
 OCT - 1 1980
 RECEIVED

If well telescopes please sketch and show depths.

GROUND LEVEL

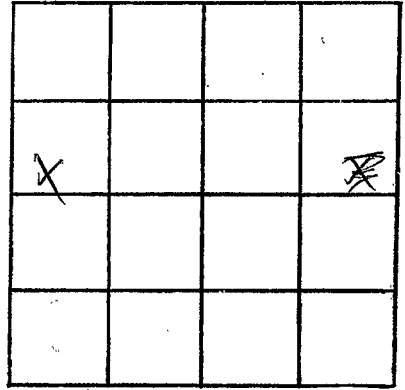

SECTION 13

Please indicate well location X.

ADDITIONAL INFORMATION

If more than one screen,
show locations of each on sketch.