

MISSISSIPPI DEPARTMENT OF NATURAL RESOURCES

Bureau of Land and Water Resources

Southport Mall

P.O. Box 10631

Jackson, Mississippi 39209

WATER WELL DRILLERS LOG

Permit Applied For

LEFLORE No. 8581 (W-19)

Feb 29 1988 Dym Well Leflore
 date well completed firm name county well located

LANDOWNER: James C. Reddock

description of formations encountered

856 Magnolia Wood Ave
 Baton Rouge La, 70808
 (mailing address)


	from	to
Clay	0	40
fine sand	40	58
sand & gravel	58	98

148B WELL LOCATION:
 sec. 2 T. 18 N R. 1
 3 miles SE of Itha Bena
 (distance) (direction) (nearest town)

WELL PURPOSE: Irrigation
 (home, irrigation, municipal, industrial)

WELL COMPLETION DATA:

- (1) diameter (inches) 12"
- (2) total depth (feet) 98'
- (3) static water level (feet) _____ below above top of ground
- (4) casing steel (material), (depth), 12 (size) if telescope see back.
- (5) screen 40 (length), (depth to top) 12 (size), (material)
- (6) pump 30 (HP), (yield gpm) Elec (type power)
- (7) electric log No (yes or no) None (organization running log)
- (8) how well bottom plugged Plate

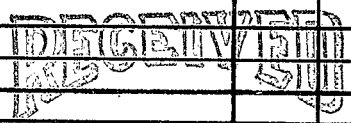


MAY 09 1988

Department of Natural Resources
 Bureau of Land & Water Resources

DRILLERS REMARKS:

If well telescopes please
sketch and show depths.

GROUND LEVEL

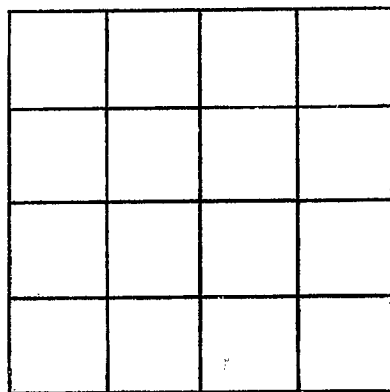

SECTION _____

Please indicate well location X.

ADDITIONAL INFORMATION

If more than one screen,
show locations of each on sketch.