

MISSISSIPPI DEPARTMENT OF NATURAL RESOURCES

Bureau of Land and Water Resources

Southport Mall

P.O. Box 10631

Jackson, Mississippi 39209

WATER WELL DRILLERS LOG

Permit Applied For

LEFORS N30 dot

3-7-88 date well completed

Dyer Well firm name

Leflore county well located

LANDOWNER: Supelo P L  
Rt 1 Box E74  
Schlater Ms.  
 (mailing address)

description of formations encountered

from to

Clay	0	28
Fine Sand	28	65
M Sand & Gravel	65	80
Sand & Gravel	80	115

WELL LOCATION:

1286  
129A sec 13 T 21 N R 1  
3 miles W of Money  
 (distance) (direction) (nearest town)

WELL PURPOSE: Irrigation  
 (home, irrigation, municipal, industrial)

WELL COMPLETION DATA:

- (1) diameter (inches) 16"
- (2) total depth (feet) 115'
- (3) static water level (feet) \_\_\_\_\_ below above top of ground.
- (4) casing steel (material), \_\_\_\_\_ (depth), 16 (size) if telescope see back.
- (5) screen 40 (length), \_\_\_\_\_ (depth to top), 16 (size), \_\_\_\_\_ (material)
- (6) pump 60 (HP), \_\_\_\_\_ (yield gpm), Gear (type power)
- (7) electric log No (yes or no), None (organization running log)
- (8) how well bottom plugged Plate

RECEIVED


MAY 02 1988

Department of Natural Resources  
 Bureau of Land & Water Resources

DRILLERS REMARKS:

If well telescopes please  
sketch and show depths.

GROUND LEVEL

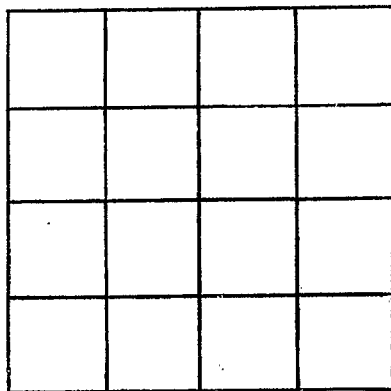

SECTION \_\_\_\_\_

Please indicate well location X.

ADDITIONAL INFORMATION

If more than one screen,  
show locations of each on sketch.