

~~022~~ N16  
5-28-63

WATER WELL DRILLERS LOG

CODED

Date: MAY 28, 1963, Driller: DELTA DRILLING Co. County LEFLORE  
(Name)

(1) Owner of Land: JAMES H. CARPENTER  
(Name)  
SIDON, MISS.  
(Address)

(2) Location: SW 1/4, SW 1/4, Sec. 26 T18N1-W  
\_\_\_\_\_ miles \_\_\_\_\_ of \_\_\_\_\_  
(distance) (direction) (Nearest Town)

(3) Topography: \_\_\_\_\_  
(Hilly) (Flat) (Level)

(4) Purpose of Well: DOMESTIC  
(Domestic Irrigation  
Municipal, Industrial, Other)

Description & Color of Materials Sand, Clay, Red Clay, Shell, etc.	Thick- ness Feet	Depth Feet
GUMBO	25	25
SAND	37	62
GRAVEL	62	124
GUMBO W/4" ROCK	88	212
SAND	210	422
GUMBO	106	528
SHALE	104	632
SAND W/6" ROCK	30	662
SHALE W/ROCK	111	773
SAND	40	813
SHALE W/ROCK	140	953
SAND	60	1013
SHALE	60	1073
WHITE SAND	60	1133

Information upon completion of well:

(1) Diameter 3 inches.

(2) Total Depth 1133 feet.

(3) Water Level WELL FLOWS feet below top of ground.

(4) Cased to 1113, Size 600 - 3", 533 - 2"


(5) Screen: Size 2", Length 20'

(6) Were any formations sealed against pollution?  
\_\_\_\_\_ yes, \_\_\_\_\_ no.

If YES depth of formation \_\_\_\_\_  
Why \_\_\_\_\_

Drillers Remarks: 20' LAP OF 2"  
IN 3" PIPE.

1113  
2  
1093  
20  
1113  
CODED

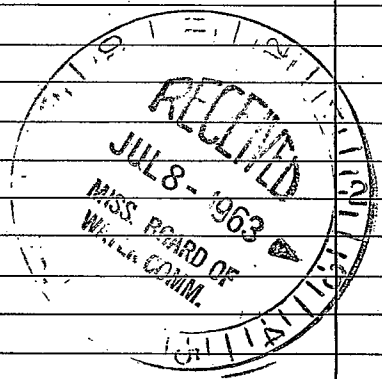

(Use Back Side)

Well No.

