

Leflore  
N 21  
6-67  
Elec Log

MISSISSIPPI  
 BOARD OF WATER COMMISSIONERS  
 416 North State Street  
 Jackson, Mississippi 39201

**CODED**

WATER WELL DRILLERS LOG

JUNE 12 1967 DELTA DRILLING CO. LEFLORE  
 date well completed firm name county well located

LANDOWNER: ROBERT E. GORE

SIDON, MISS.

(mailing address)

WELL LOCATION: NE 1/4 - NW 1/4 SE 1/4


sec. 25 T 18 N R 1 E  
 & W  
3 miles W of Sidon  
 (distance) (direction) (nearest town)

WELL PURPOSE:  
 (home, irrigation, municipal, industrial)

WELL COMPLETION DATA:

- (1) diameter (inches) 3"
- (2) total depth (feet) 1123
- (3) static water level (feet) FLOW <sup>below</sup> above top of ground.
- (4) casing BLK STEEL, 1078,  
 (material) (depth)  
3+2" If telescope see back.  
 (size)
- (5) screen 20, 1078  
 (length) (depth to top)  
2", STAINLESS STEEL  
 (size) (material)
- (6) pump  (HP) 60  
 (yield gpm)  
  
 (type power)
- (7) electric log YES  
 (yes or no)  
GEOLOGICAL SURVEY  
 (organization running log)
- (8) how well bottom plugged BACK  
PRESSURE VALVE

description of formations encountered	from	to
Top Soil & sand	0	42
gravel	42	106
Sand w/ROCKS	106	157
Gumbo	157	202
Sand	202	222
Shale	222	253
Sand	253	295
Shale	295	317
Sand	317	357
Shale	357	376
Sand	376	406
Gumbo	406	430
Shale	430	474
Sand <b>CODED</b>	474	513
Green Shale	513	544
Green Sand	544	668
Shale	668	714
Green Sand	714	844
Green Shale	844	880
Green Sand	880	914
GUMBO	914	926
Shale	926	1000
Sand	1000	1034
Shale	1034	1042
Sand	1042	1123

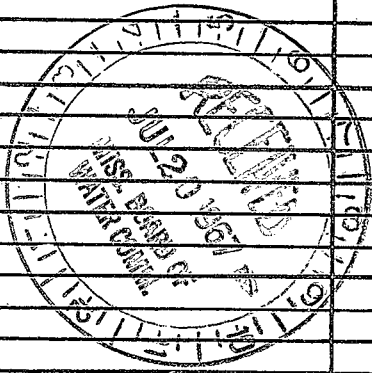

DRILLERS REMARKS: 25'-2" TAIL  
PIPE ON BOTTOM OF WELL

If well telescopes please sketch and show depths.

GROUND LEVEL

100'-3" BLK  
API LINE PIPE


24'-LAP OF  
2" IN 3" PIPE

427'-2" BLK  
LINE PIPE

1078'  
20'-2" S.S.  
SCREEN

25'-2" BLK  
API LINE PIPE

1123' T.D

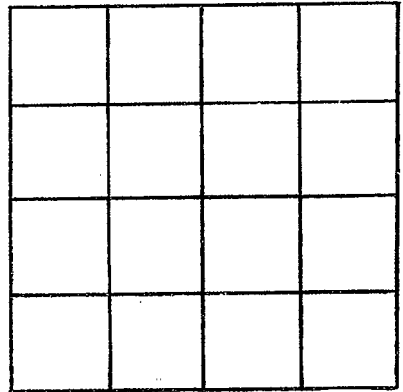

SECTION 25

Please indicate well location X.

ADDITIONAL INFORMATION

If more than one screen,  
show locations of each on sketch.