

CODED

MISSISSIPPI BOARD OF WATER COMMISSION
416 North State Street
Jackson, Mississippi 39201

CODED
CODED
CODED

WATER WELL DRILLERS LOG

Le flare
N 22
10-18-68

10/18/68
date well completed

Buttawise Gas Co. of Greenwood
firm name

Le flare
county well located

LANDOWNER:

Jessie CARTER

Edna Bena, Miss.
(mailing address)

WELL LOCATION:

sec 9 T 18 N R 1E
S W
1/4 miles W of Quito
(distance) (direction) (nearest town)

WELL PURPOSE: None
(home, irrigation, municipal, industrial)

WELL COMPLETION DATA:

- (1) diameter (inches) 2"
- (2) total depth (feet) 1080
- (3) static water level (feet) 24 ^{below} above top of ground.
- (4) casing Steel, 1060,
(material) (depth)
2"
(size) if telescope see back.
- (5) screen 20', 1060
(length) (depth to top)
2", Stainless Steel
(size) (material)
- (6) pump 3/4, 12
(HP) (yield gpm)
Elec.
(type power)
- (7) electric log No
(yes or no)

(organization running log)

(8) how well bottom plugged Back pressure valve

DRILLERS REMARKS:

description of formations encountered


from to

clay	0	18
sand	18	80
sand + gravel	80	140
clay	140	200
sand + shale	200	280
green sand	280	340
clay	340	500
shale	500	590
sand + shale	590	730
shale	730	930
green CODED	930	950
clay CODED	950	1060
white sand	1060	1090

OCT 20 1968
MISS. BOARD OF
WATER COM.

If well telescopes please
sketch and show depths.

GROUND LEVEL

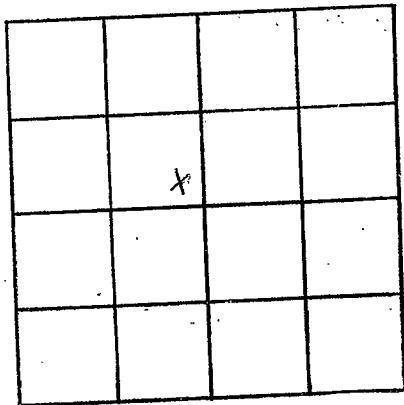

SECTION 9

Please indicate well location X.

ADDITIONAL INFORMATION

If more than one screen,
show locations of each on sketch.