

Leflore
 N 23
 11-18-68

MISSISSIPPI
 BOARD OF WATER COMMISSIONERS
 416 North State Street
 Jackson, Mississippi 39201

CODED
 CODED

WATER WELL DRILLERS LOG

11-18 date well completed 1968 DYER WELL? IRR. firm name LEFLORE county well located

LANDOWNER:

MACIE KIMBROUGH

description of formations encountered

from

to

SIDON, MISS.

(mailing address)

CLAY	0	28
SAND	28	33
BLUE CLAY	33	42
SAND + GRAVEL	42	63
FINE SAND	63	72
MED. SAND + PEA GRAVEL	72	83
CR. SAND + GRAVEL	83	103

WELL LOCATION:

sec. 17 T. 17 N. R. 1 E. W. MORGAN CITY
 2 1/2 miles S.E. of (distance) (direction) (nearest town)

WELL PURPOSE: IRR. (home, irrigation, municipal, industrial)

WELL COMPLETION DATA:

- (1) diameter (inches) 16"
- (2) total depth (feet) 103'
- (3) static water level (feet) 10' below top of ground.
- (4) casing BLK. IR. (material) 63' (depth)
16" (size) If telescope see back.
- (5) screen 40' (length) 63' (depth to top)
16" (size) BLK. IR. (material)
- (6) pump 60 (HP) 3,000 (yield gpm)
DIESEL (type power)
- (7) electric log No (yes or no)

CODED

(organization running log)

(8) how well bottom plugged PLATE

JAN 21 1969


MISS. BD. OF WATER COM.

DRILLERS REMARKS:

112
 00
 11

If well telescopes please sketch and show depths.

GROUND LEVEL

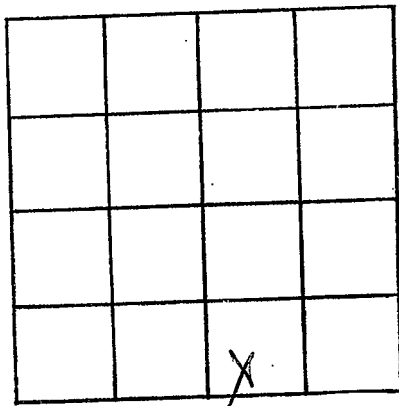

SECTION 17

Please indicate well location X.

ADDITIONAL INFORMATION

If more than one screen, show locations of each on sketch.