

LEFLORE
N 30
10-4-74

MISSISSIPPI
BOARD OF WATER COMMISSIONERS
 416 North State Street
 Jackson, Mississippi 39201

WATER WELL DRILLERS LOG **CODED**

10-4-74 1974 LEUTANE GAS CO. OF GREENWOOD Leflore
 date well completed firm name county well located

LANDOWNER:
S.W. BLACK
Sidon
 (mailing address)

WELL LOCATION:
 sec. 34 T. 18N R. 1E
5 miles SW of Sidon
 (distance) (direction) (nearest town)

WELL PURPOSE: Home
 (home, irrigation, municipal, industrial)

- WELL COMPLETION DATA:**
- (1) diameter (inches) 3x2
 - (2) total depth (feet) 1130
 - (3) static water level (feet) 25 ^{below} above ground.
 - (4) casing Steel, 1100
 (material) (depth)
3x2 if telescope see back.
 (size)
 - (5) screen 30', 1100
 (length) (depth to top)
2", Stainless
 (size) (material)
 - (6) pump _____ (HP) _____ (yield gpm)
 _____ (type power)
 - (7) electric log _____ (yes or no)
 _____ (organization running log)
 - (8) how well bottom plugged Lead PIG

description of formations encountered	from	to
Clay	0	30
SAND	30	60
SAND + GRAVEL	60	130
SAND + Clay	130	180
Silt	180	440
Clay	440	580
SAND + Clay	580	600
Green Sand	600	915
Clay	915	965
SAND + Silt	965	1050
SAND	1050	1174
CODED		
RECEIVED		
OCT 15 1974		
R COMM		

DRILLERS REMARKS:


If well telescopes please sketch and show depths.

GROUND LEVEL

105' - 3" CASING →

995' - 2" CASING →

30' - 2" SCREEN →

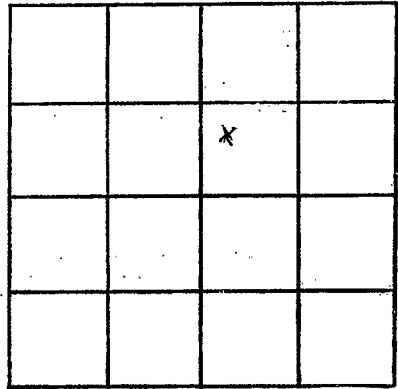

SECTION 34

Please indicate well location X.

ADDITIONAL INFORMATION

Lined area for additional information.

If more than one screen, show locations of each on sketch.