

Leflore
N 32
6-66

MISSISSIPPI BOARD OF WATER COMMISSIONERS

WATER WELL DRILLERS LOG

CODED

Date: 6/30, 1966, Driller: Butane Gas Co., County Leflore
(Name)


(1) Owner of Land: William Kimbrough
(Name)
Morgan City, Miss.
(Address)
(2) Location: SE 1/4, NE 1/4, Sec. 21 T18N R2W
3 1/2 miles NE of Morgan City,
(distance) (direction) (Nearest Town)
(3) Topography: (Hilly) (Flat) (Level)
(4) Purpose of Well: Irrigation
(Domestic Irrigation
Municipal, Industrial, Other)

Description & Color of Materials Sand, Clay, Red Clay, Shell, etc.	Thick- ness Feet	Depth Feet
Clay	13	13
Clay	10	23
Brown Sand	10	33
Brown Sand	10	43
Fine Sand	10	53
Coarse Sand, Gravel	10	63
Coarse Sand, Gravel	10	73
Coarse Sand, Gravel	10	83
Coarse Sand, Gravel	10	93
Coarse Sand, Gravel	10	103

Information upon completion of well:

(1) Diameter 12 inches.
(2) Total Depth 103 feet.
(3) Water Level 23 feet below top of ground.
(4) Cased to 63, Size 12
(5) Screen: Size 12, Length 40
(6) Were any formations sealed against pollution?
_____ yes, _____ no.

If YES depth of formation _____
Why _____
Drillers Remarks: _____

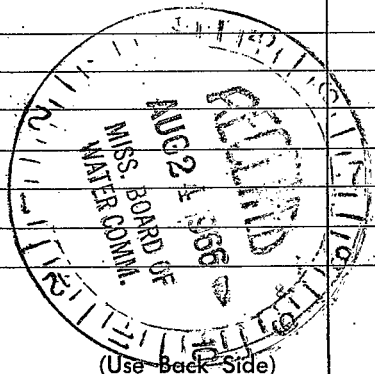

Well No.

