

MISSISSIPPI BOARD OF WATER COMMISSIONERS

Leflore
N 33
B-66

WATER WELL DRILLERS LOG CODED

Date: 8/1, 1966, Driller: Butane Gas Co. County: Leflore
(Name)

- (1) Owner of Land: Mack Kimbrough
(Name)
Morgan City, Miss.
(Address)
- (2) Location: SE 1/4, NE 1/4, Sec. 22 TN RW, 18 1
6 miles west, of Sidon
(distance) (direction) (Nearest Town)
- (3) Topography: (Hilly) (Flat) (Level)
- (4) Purpose of Well: Irrigation
(Domestic Irrigation, Municipal, Industrial, Other)

Description & Color of Materials Sand, Clay, Red Clay, Shell, etc.	Thick- ness Feet	Depth Feet
Clay	13	13
Clay	10	23
Clay	10	33
Fine Sand	10	43
Fine Sand	10	53
Coarse Sand, Gravel	10	63
Coarse Sand, Gravel	10	73
Coarse Sand, Gravel	10	83
Coarse Sand, Gravel	10	93
Coarse Sand, Gravel	10	103


Information upon completion of well:

- (1) Diameter 12 inches.
- (2) Total Depth 103 feet.
- (3) Water Level 23 feet below top of ground.
- (4) Cased to 63, Size 12
- (5) Screen: Size 12, Length 40
- (6) Were any formations sealed against pollution?
yes, no.

If YES depth of formation _____

Why _____

Drillers Remarks: _____

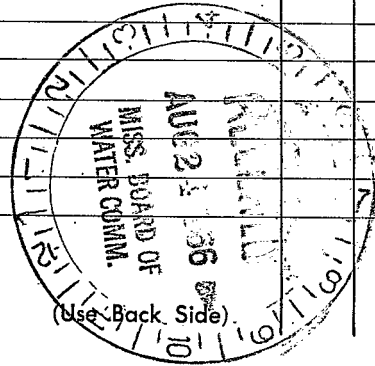

Well No.

tain this copy for your office files.

