

MISSISSIPPI  
BOARD OF WATER COMMISSIONERS  
416 North State Street  
Jackson, Mississippi 39201

WATER WELL DRILLERS LOG


CODED

LeFlore  
N 34  
4-67

April 24 1967 Butane Gas of LeFlore  
date well completed firm name Greenwood county well located


LANDOWNER: <u>FRED POWDEXTER</u>	description of formations encountered	from	to
<u>Morgan City, Miss</u> (mailing address)	<u>Clay</u> <u>Fine Brown Sand</u> <u>Coarse Sand &amp; Fine Gravel</u>	<u>0</u> <u>10</u> <u>50</u>	<u>10</u> <u>50</u> <u>105</u>
<p>WELL LOCATION:</p> <p>sec <u>21</u> T <u>18</u> N R <u>1</u> E W</p> <p><u>1</u> miles <u>N</u> of <u>Morgan City</u> (distance) (direction) (nearest town)</p>			
<p>WELL PURPOSE: <u>IRRIGATION</u> (home, irrigation, municipal, industrial)</p>			
<p>WELL COMPLETION DATA:</p> <p>(1) diameter (inches) <u>16"</u></p> <p>(2) total depth (feet) <u>105'</u></p> <p>(3) static water level (feet) <u>18</u> below top of ground.</p> <p>(4) casing <u>Black</u>, <u>65'</u> (material) (depth) <u>16"</u> (size) if telescope see back.</p> <p>(5) screen <u>40'</u>, <u>65'</u> (length) (depth to top) <u>16"</u>, <u>Black Steel</u> (size) (material)</p> <p>(6) pump <u>70</u> <u>2500</u> (HP) (yield gpm) <u>LPG</u> (type power)</p> <p>(7) electric log <u>No</u> (yes or no)  (organization running log)</p> <p>(8) how well bottom plugged <u>STEEL PLATE</u></p>			
<p>DRILLERS REMARKS:</p>			

CODED

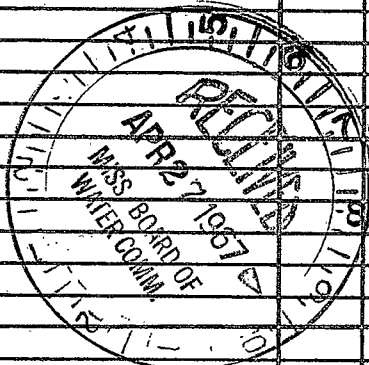

If well telescopes please sketch and show depths.

GROUND LEVEL

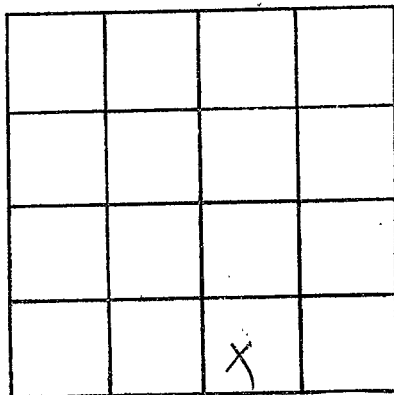

SECTION 21

Please indicate well location X.

ADDITIONAL INFORMATION

If more than one screen,  
show locations of each on sketch.