

Leflore
 N 36
 12-67

MISSISSIPPI
 BOARD OF WATER COMMISSIONERS
 416 North State Street
 Jackson, Mississippi 39201

CODED

WATER WELL DRILLERS LOG

DEC. 26, 1967 DELTA DRILLING COMPANY LEFLORE
 date well completed firm name county well located


LANDOWNER: LEO MOSS
 RT 1, SIDON, MISS.
 (mailing address)
 WELL LOCATION: NW 1/4 SE 1/4
 sec. 26 T. 18 N R. 1 E
 S W
 1/2 miles N of PHILLIPSTON
 (distance) (direction) (nearest town)

description of formations encountered	from	to
Gumbo	0	24
Sand	24	60
gravel	60	116
Gumbo	116	160
Sand	160	407
Shale	407	439
Gumbo	439	458
Green sand	458	490
Shale	490	551
Green sand	551	745
Shale	745	797
Green sand	797	905
Shale	905	951
Green sand	951	977
Gumbo	977	1028
Shale	1028	1040
Sand	1040	1142
Gumbo	1142	1150

WELL PURPOSE: DOMESTIC
 (home, irrigation, municipal, industrial)

WELL COMPLETION DATA:
 (1) diameter (inches) 3"
 (2) total depth (feet) 1150
 (3) static water level (feet) FLOWS below top of ground.
 (4) casing STEEL, (material), (depth) 3+2" if telescope see back. (size)
 (5) screen 20' SEE REVERSE (length) (depth to top)
 2" S.S. SCREEN (size) (material)
 (6) pump (HP) (yield gpm)
 (type power)
 (7) electric log No. (yes or no)
 (organization running log)
 (8) how well bottom plugged BACK PRESSURE VALVE

DRILLERS REMARKS: 20' LAP OF 2" IN 3" PIPE -

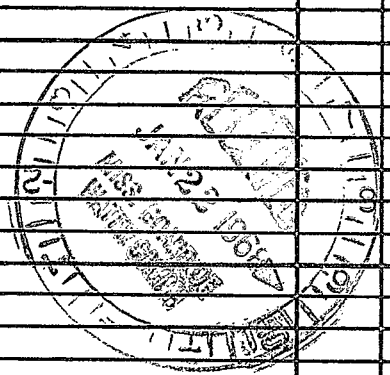

If well telescopes please sketch and show depths.

GROUND LEVEL

600' - 3" BLK
A.P.T. LINE PIPE

20' LAP OF
2" IN 3" PIPE


480' - 2" BLK
LINE PIPE

10' 2" S.S.
SCREEN

50' 2" BLK
A.P.T. LINE PIPE

10' 2" S.S.
SCREEN

10' 2" BLK.
TAIL PIPE

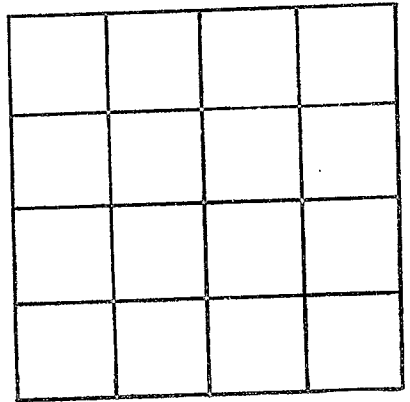

SECTION 26

Please indicate well location X.

ADDITIONAL INFORMATION

If more than one screen,
show locations of each on sketch.