

LEFLORE
 N 37
 4-68

MISSISSIPPI
 BOARD OF WATER COMMISSIONERS
 416 North State Street
 Jackson, Mississippi 39201 **CODED**

WATER WELL DRILLERS LOG

4-8-68 date well completed 19 Butane Gas Co. of Greenwood firm name Leflore county well located

LANDOWNER:
 J. W. Stowers
 Itha Benn, Miss.
 (mailing address)

description of formations encountered	from	to
clay	0	2.5
SAND + GRAVEL	2.5	10.3

WELL LOCATION:
 sec. 17 T 18 N R 1 E
 S W
 5 miles S of Itha Benn Miss.
 (distance) (direction) (nearest town)

WELL PURPOSE: Irrigation
 (home, irrigation, municipal, industrial)

WELL COMPLETION DATA:

(1) diameter (inches) 16"

(2) total depth (feet) 10.3

(3) static water level (feet) 20 below above top of ground.

(4) casing Steel 55' (material) (depth)
 16" (size) if telescope see back.

(5) screen 40' 55' (length) (depth to top)
 16" Steel (size) (material)


(6) pump 65 2000 (HP) (yield gpm)
 LP GAS ENGINE (type power)

(7) electric log NO (yes or no)
 (organization running log)

(8) how well bottom plugged Steel Plate


CODED

DRILLERS REMARKS: CR

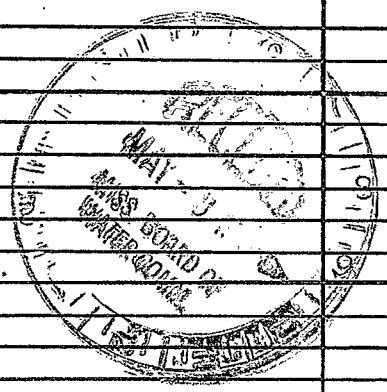

If well telescopes please sketch and show depths.

GROUND LEVEL

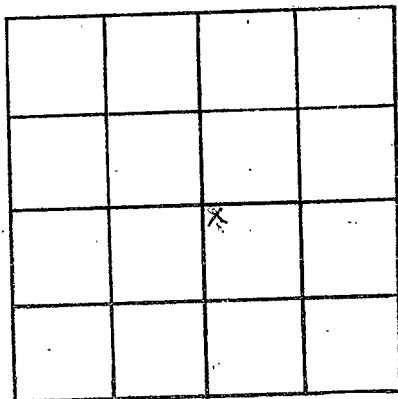

SECTION 17

Please indicate well location X.

ADDITIONAL INFORMATION

If more than one screen,
show locations of each on sketch.