

LEFLORE
N 38
4-68

MISSISSIPPI
BOARD OF WATER COMMISSIONERS
416 North State Street
Jackson, Mississippi 39201

WATER WELL DRILLERS LOG

4-12-68 date well completed 19 Buttrick Gas Co. of Greenwood firm name LeFlore county well located

LANDOWNER:	description of formations encountered	from	to
Ocia Alderman	Clay	0	16
Sidon Miss. (mailing address)	Sand	16	46
	Sand + Gravel	46	128
WELL LOCATION:	Clay	128	305
sec. 25 T 18 N R 1 E S W	Sand + Shale	305	562
2 1/2 miles SW of Sidon (distance) (direction) (nearest town)	Clay + Shale	562	874
	Sand + Shale	874	933
WELL PURPOSE: Home (home, irrigation, municipal, industrial)	Shale	933	963
WELL COMPLETION DATA:	Hard packed Sand	963	1004
(1) diameter (inches) 4 3/4	Sand	1004	1051
(2) total depth (feet) 1321	Clay	1051	1062
(3) static water level (feet) 26 below top of ground.	Sand	1062	1084
(4) casing 5/8" (material), 1266 (depth)	Clay + Shale	1084	1118
4 X 2 (size) if telescope see back.	Sand	1118	1140
(5) screen 30' (length), 1266 (depth to top)	Shale	1140	1200
2" (size), Stainless Steel (material)	Rock	1200	1201
(6) pump 20 (HP), 20 (yield gpm)	Shale	1201	1231
(7) electric log No (yes or no)	Rock	1231	1232
(organization running log)	Sand	1232	1251
(8) how well bottom plugged	Coarse White Sand	1251	1298
	Shale	1298	1321

DRILLERS REMARKS:

MISS. Bd. OF WATER COMMISSIONERS


If well telescopes please sketch and show depths.

GROUND LEVEL

105' - 4" Galv.
CASING →

116' - 2" Galv.
CASING →

50' - 2"
Stainless Steel
SCREEN →

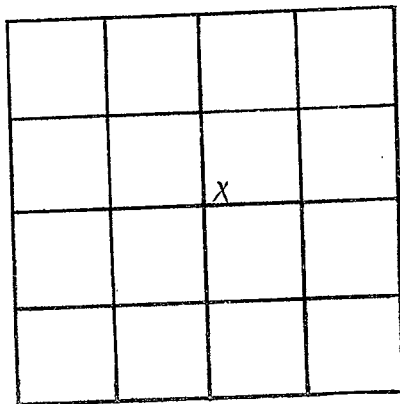

SECTION 25

Please indicate well location X.

ADDITIONAL INFORMATION

If more than one screen,
show locations of each on sketch.