

Leflore
 N 39
 6-68

MISSISSIPPI
 BOARD OF WATER COMMISSIONERS
 416 North State Street
 Jackson, Mississippi 39201

CODED

WATER WELL DRILLERS LOG

6-22-68 date well completed 19 Butane Gas Co. of Greenwood firm name Leflore county well located

LANDOWNER:
 F. R. MORGAN
 MORGAN City, Miss.
 (mailing address)

WELL LOCATION:
 sec. 29 T. 18 N R. 1 E
 2 miles EAST of MORGAN City
 (distance) (direction) (nearest town)


WELL PURPOSE: Home
 (home, irrigation, municipal, industrial)

WELL COMPLETION DATA:

- (1) diameter (inches) 4 3/4
- (2) total depth (feet) 1159
- (3) static water level (feet) 30 below top of ground.
- (4) casing Steel, 1129 (material), (depth)
 4 x 2 (size) if telescope see back.
- (5) screen 30' (length), 1129 (depth to top)
 2" Stainless Steel (size), (material)
- (6) pump 1 1/2 (HP), 30 (yield gpm)
 Elec. (type power)
- (7) electric log NO (yes or no)
 (organization running log)
- (8) how well bottom plugged
 Back Wash Valve

description of formations encountered	from	to
CLAY	0	10
SAND	10	60
SAND + GRAVEL	60	150
CLAY	150	293
SAND	293	400
CLAY	400	427
SAND	427	490
SHALE	490	1000
SAND + SHALE	1000	1073
FINE SAND	1073	1093
White SAND	1093	1159

CODED

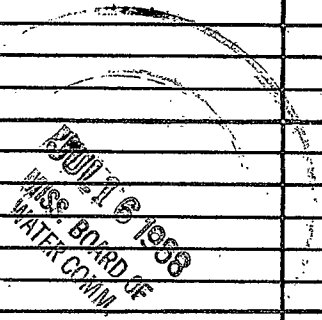

DRILLERS REMARKS:

