

Leflore
N 40
8-13-68

MISSISSIPPI
 BOARD OF WATER COMMISSIONERS
 416 North State Street
 Jackson, Mississippi 39201

CODED

WATER WELL DRILLERS LOG

8/13/68 19 *Buttwe Gas Co of Greenwood* *Leflore*
 date well completed firm name county well located

LANDOWNER:
J. W. Stowers
Itha Bena, Miss.
 (mailing address)


description of formations encountered	from	to
	<i>Clay</i>	<i>0</i>
<i>Sand</i>	<i>40</i>	<i>60</i>
<i>SAND + GRAVEL</i>	<i>60</i>	<i>96</i>

WELL LOCATION:
 sec. *17* T. *18* N R. *1* W
5 miles *SW* of *Itha Bena*
 (distance) (direction) (nearest town)

CODED

WELL PURPOSE: *TRR*
 (home, irrigation, municipal, industrial)

- WELL COMPLETION DATA:
- (1) diameter (inches) *10"*
 - (2) total depth (feet) *96*
 - (3) static water level (feet) _____ below/above top of ground.
 - (4) casing *Steel* *76*
 (material) (depth)
10" if telescope see back.
 (size)
 - (5) screen *20'* *76*
 (length) (depth to top)
10" *Steel*
 (size) (material)
 - (6) pump *20* *700*
 (HP) (yield gpm)
Tractor
 (type power)
 - (7) electric log *NO*
 (yes or no)

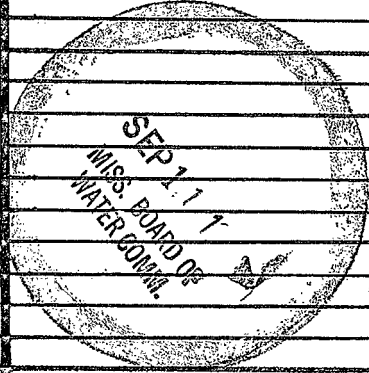

(organization running log)

(8) how well bottom plugged
Steel plate welded

DRILLERS REMARKS: *CR*

