

LeFlore
~~26~~ N 41
 8-68

MISSISSIPPI
 BOARD OF WATER COMMISSIONERS
 416 North State Street
 Jackson, Mississippi 39201

CODED

WATER WELL DRILLERS LOG

8-10-68 date well completed
 19 Rustane Gas Co. of Wood firm name
 LeFlore county well located

LANDOWNER:

Paul Lape
 Itha Bena, Miss.
 (mailing address)

description of formations encountered

	from	to
Clay	0	23
Sand	23	48
Sand + Gravel	48	173
Shale	173	233
Sandy Shale	233	732
Rock	732	735
Sand + Shale	735	899
Sandy Shale	899	957
Sand	957	1053
Shale	1053	1065


WELL LOCATION:
 sec. 2 T. 18 N R. 4 W
 4 miles SW of Wood
 (distance) (direction) (nearest town)

WELL PURPOSE: Home
 (home, irrigation, municipal, industrial)

WELL COMPLETION DATA:

- (1) diameter (inches) 4 3/4
- (2) total depth (feet) 1038
- (3) static water level (feet) 15 below top of ground.
- (4) casing Steel (material), 1008 (depth),
4" x 2" (size) if telescope see back.
- (5) screen 30 (length), 1008 (depth to top),
2" (size), Stainless Steel (material)
- (6) pump 2 (HP), 40 (yield gpm),
Elec. (type power)
- (7) electric log NO (yes or no)
 (organization running log)
- (8) how well bottom plugged Back Pressure Valve

CODED

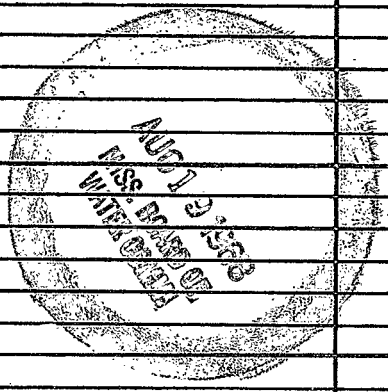

DRILLERS REMARKS: WG

