

Leflore
 N 43
 10-2-75

MISSISSIPPI
 BOARD OF WATER COMMISSIONERS
 416 North State Street
 Jackson, Mississippi 39201
 WATER WELL DRILLERS LOG

CODED


10-2-75 19 BUTANE GAS CO. OF GREENWOOD Leflore
 date well completed firm name county well located

LANDOWNER:	description of formations encountered	from	to
L. C. Hodges Sidon (mailing address)			
WELL LOCATION:			
sec. 34 T 18 N R 1 E 15 S 6 miles SW of Sidon (distance) (direction) (nearest town)			
WELL PURPOSE: Home (home, irrigation, municipal, industrial)			
WELL COMPLETION DATA:			
(1) diameter (inches) 2			
(2) total depth (feet) 65			
(3) static water level (feet) 15 below top of ground.			
(4) casing PVC - 55' (material) (depth) 2" If telescope see back. (size)			
(5) screen 10' 55' (length) (depth to top) 2" PVC (size) (material)			
(6) pump 3/4 10 (HP) (yield gpm) Elec. (type power)			
(7) electric log NO (yes or no) (organization running log)			
(8) how well bottom plugged			
DRILLERS REMARKS:			

OCT - 6 1975
 MISS. Bd. OF WATER COMMISSIONERS

If well telescopes please sketch and show depths.

GROUND LEVEL

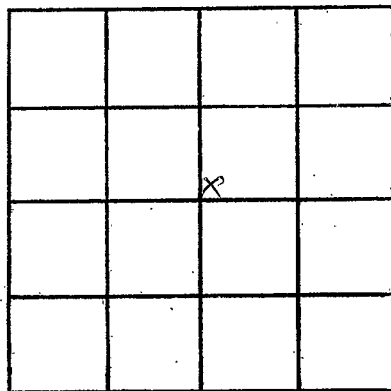

SECTION 34

Please indicate well location X.

ADDITIONAL INFORMATION

If more than one screen, show locations of each on sketch.