

LEFLORE

N46

5-25-79

MISSISSIPPI
 BOARD OF WATER COMMISSIONERS
 416 North State Street
 Jackson, Mississippi 39201

CODED

WATER WELL DRILLERS LOG

5/25

1979

DYER WELL + IRR

LEFLORE

date well completed

firm name

county well located

LANDOWNER:

LARRY BENNETT

ITTA BENA

(mailing address)

WELL LOCATION:

sec. 7 T 19 (N) R. 1 E
 18 S W
3 miles SW of ITTA BENA
 (distance) (direction) (nearest town)

WELL PURPOSE:

(home irrigation, municipal, industrial)

WELL COMPLETION DATA:

- (1) diameter (inches) 12
- (2) total depth (feet) 100
- (3) static water level (feet) 18 below
top of ground.
- (4) casing STEEL, 60
(material) (depth)
12 If telescope see back.
(size)
- (5) screen 40, 60
(length) (depth to top)
12, STEEL
(size) (material)
- (6) pump 25, 1500
(HP) (yield gpm)
ELECTRIC
(type power)
- (7) electric log NO
(yes or no)

(organization running log)

(8) how well bottom plugged. PLATE

DRILLERS REMARKS:

description of formations encountered

from

to

CLAY	0	20
FINE SAND	20	25
SAND	25	40
SAND + GRAVEL	40	100

CODED


DEPT. OF NATURAL RESOURCES
 BUREAU OF LAND & WATER RESOURCES

OCT 29 1979

RECEIVED

If well telescopes please sketch and show depths.

GROUND LEVEL

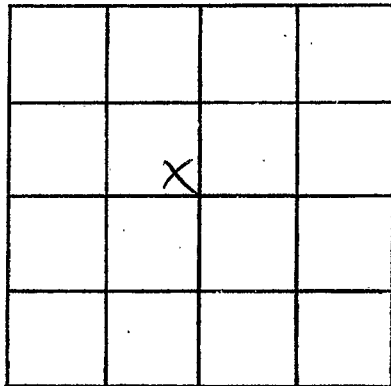

SECTION 7

Please indicate well location X.

ADDITIONAL INFORMATION

If more than one screen, show locations of each on sketch.