

LEFLORE

N-47

8/15/80

August 15

date well completed

MISSISSIPPI BOARD OF WATER COMMISSIONERS  
416 North State Street  
Jackson, Mississippi 39201

CODED

WATER WELL DRILLERS LOG

BUTANE GAS COMPANY

OF GREENWOOD

LEFLORE

county well located

LANDOWNER: JAMES STOWERS

ITHA BENA, MS

(mailing address)

WELL LOCATION:

sec. 17 T18 N R1 E  
1 miles SW of Quito  
(distance) (direction) (nearest town)

WELL PURPOSE: IRRIGATION  
(home, irrigation, municipal, industrial)

WELL COMPLETION DATA:

- (1) diameter (inches) 12"
- (2) total depth (feet) 100 ft
- (3) static water level (feet) 15' below top of ground.
- (4) casing STEEL, 60' (material) (depth)
- (size) if telescope see back.
- (5) screen 40', 60' (length) (depth to top)
- 10" STEEL (size) (material)
- (6) pump 20 HP, 800 (yield gpm)
- PROPANE (type power)
- (7) electric log No (yes or no)
- No (organization running log)
- (8) how well bottom plugged STEEL PLATE

description of formations encountered

from to

Clay	0	10
Clay & FINE SAND	10	20
SAND & GRAVEL	20	60
SAND GRAVEL & ROCK	60	100

DRILLERS REMARKS:


DEPT. OF NATURAL RESOURCES  
BUREAU OF LAND & WATER RESOURCES  
AUG 21 1980  
RECEIVED

If well telescopes please sketch and show depths.

GROUND LEVEL

60 FT  
12" STEEL  
CASING

40 FT  
10" STEEL  
SCREEN

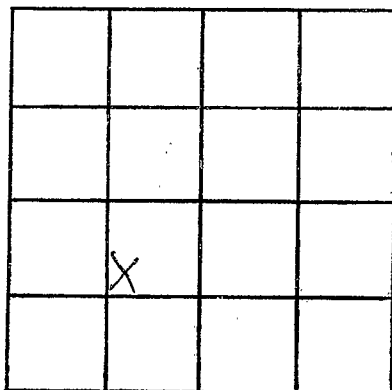

SECTION 17

Please indicate well location X.

ADDITIONAL INFORMATION

If more than one screen,  
show locations of each on sketch.