

N-48  
LEFLORE  
9-5-80

MISSISSIPPI  
BOARD OF WATER COMMISSIONERS  
416 North State Street  
Jackson, Mississippi 39201

WATER WELL DRILLERS LOG

CODED

9/5 1980 DYER WELL + Irrigation LeFlore  
date well completed firm name county well located

LANDOWNER:  
BLACK BOTTOM  
P.O. BOX 173  
INVERNESS, MISS 38753  
(mailing address)

description of formations encountered	from	to
Clay	0	42
Sand	42	48
Sand + Gravel	48	103

WELL LOCATION:  
sec 32 T 18 N R 1 E  
Two (2) miles East of Morgan City  
(distance) (direction) (nearest town)

WELL PURPOSE: Irrigation  
(home, irrigation, municipal, industrial)

WELL COMPLETION DATA:

(1) diameter (inches) 16"

(2) total depth (feet) 103'

(3) static water level (feet) 23' below  
top of ground.

(4) casing Steel, 63'  
(material) (depth)  
16" if telescope see back.  
(size)

(5) screen 40', 63'  
(length) (depth to top)  
16", STEEL  
(size) (material)

(6) pump 600 3,000  
(HP) (yield gpm)  
DIESEL  
(type power)


(7) electric log NO  
(yes or no)  
  
(organization running log)

(8) how well bottom plugged Plate

CODED

DRILLERS REMARKS:

GROUND LEVEL

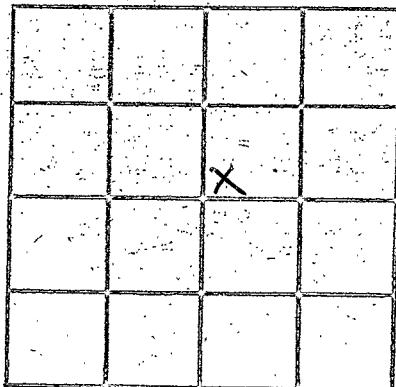

SECTION \_\_\_\_\_

Please indicate well location X.

ADDITIONAL INFORMATION

If more than one screen,  
show locations of each on sketch.