

MISSISSIPPI DEPARTMENT OF NATURAL RESOURCES

Bureau of Land and Water Resources

Southport Mall

P.O. Box 10631

Jackson, Mississippi 39209

WATER WELL DRILLERS LOG

LEFLORE  
MS-GW-02885  
N52

Wad

11-5 1987  
 date well completed

Dyer Well  
 firm name

Leflore  
 county well located

LANDOWNER: H. E. M. Party

description of formations encountered

from

to

505 Basket St.

Clay

0

28

IHA Bend Ms. 38941  
 (mailing address)

Fine Sand

28

38

M Sand & Gravel

38

68

Sand & Gravel

68

106


WELL LOCATION:

sec. 4 T 18 N R 1  
3 miles S of IHA Bend  
 (distance) (direction) (nearest town)

WELL PURPOSE: Irrigation  
 (home, irrigation, municipal, industrial)

WELL COMPLETION DATA:

- (1) diameter (inches) 16"
- (2) total depth (feet) 106'
- (3) static water level (feet) \_\_\_\_\_ below top of ground.
- (4) casing Steel (material) \_\_\_\_\_ (depth) \_\_\_\_\_  
16" (size) if telescope see back.
- (5) screen 40' (length) \_\_\_\_\_ (depth to top) \_\_\_\_\_  
16" (size) \_\_\_\_\_ (material)
- (6) pump 30 (HP) 1500 (yield gpm)
- Electric (type power)
- (7) electric log No (yes or no)  
None (organization running log)
- (8) how well bottom plugged Plate

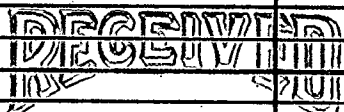


FFR 01 1988

Department of Natural Resources  
 Bureau of Land & Water Resources

DRILLERS REMARKS:

If well telescopes please sketch and show depths.

GROUND LEVEL

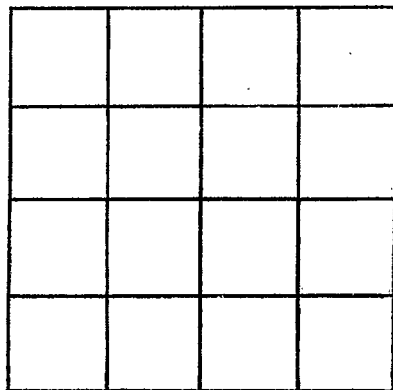

SECTION \_\_\_\_\_

Please indicate well location X.

ADDITIONAL INFORMATION

If more than one screen,  
show locations of each on sketch.