

LEFLORE

N 54

10/2/90

MISSISSIPPI BOARD OF WATER COMMISSIONERS
416 North State Street
Jackson, Mississippi 39201

CODED

WATER WELL DRILLERS LOG

RUTANE GAS COMPANY

Oct 2

date well completed

1990

OF GREENWOOD

LEFLORE

county well located

LANDOWNER: DR. EUGENE WEBB

description of formations encountered

from to

ITTA BENA, MS

Clay	0	16
SAND	16	60
SAND & GRAVEL	60	130
Clay	130	208
SAND	208	260
Clay	260	390
SHALE	390	530
SHALE & SAND	530	600
SAND	600	670

(mailing address)

WELL LOCATION:

sec. 4 T. 18 N R. 1 E
3 miles South East of ITTA BENA
(distance) (direction) (nearest town)

WELL PURPOSE: HOME
(home, irrigation, municipal, industrial)

WELL COMPLETION DATA:

- (1) diameter (inches) 4x2"
- (2) total depth (feet) 650
- (3) static water level (feet) 20 below top of ground
- (4) casing Galv 630' (material) (depth)
4x2" if telescope see back. (size)
- (5) screen 20' 630' (length) (depth to top)
2" STAINLESS STEEL (size) (material)
- (6) pump 1/2 10 (HP) (yield gpm)
ELECTRIC (type power)
- (7) electric log No (yes or no)
No (organization running log)

DEPT. OF NATURAL RESOURCES
BUREAU OF LAND & WATER RESOURCES

OCT 10 1990

RECEIVED

DRILLERS REMARKS:

(8) how well bottom plugged
BACK PRESSURE VALVE


If well telescopes please sketch and show depths.

GROUND LEVEL

105' 4" GALV

525' 2" GALV

20' 2" STAINLESS SCREEN

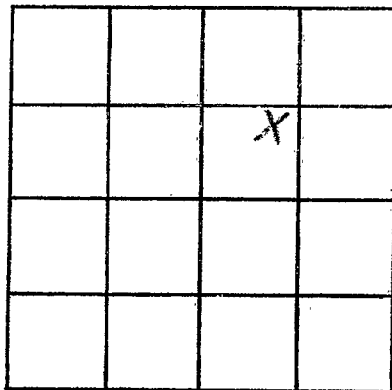

SECTION 4

Please indicate well location X.

ADDITIONAL INFORMATION

If more than one screen, show locations of each on sketch.