

MISSISSIPPI DEPARTMENT OF NATURAL RESOURCES

Bureau of Land and Water Resources

Southport Mall

P.O. Box 10631

Jackson, Mississippi 39209

WATER WELL DRILLERS LOG

CODED

LEFLORE  
 CL-2323  
N57  
3-10-83

3-10 1983 LAYNE-CENTRAL COMPANY Leflore  
 date well completed firm name county well located

LANDOWNER:	description of formations encountered	from	to
Phillipston Water Assn. Sidon, MS 38954 (mailing address)			
WELL LOCATION: sec. <u>26</u> T. <u>18</u> N R. <u>1</u> E 4 miles west of Sidon (distance) (direction) (nearest town)	sand	17	43
	coarse sand	43	68
WELL PURPOSE: (home, irrigation, municipal, industrial)	coarse sand/pea gravel	68	82
	gravel	82	152
WELL COMPLETION DATA: (1) diameter (inches) <u>21"</u> (2) total depth (feet) <u>1108'</u> (3) static water level (feet) <u>flowing below top of ground.</u> (4) casing <u>steel</u> <u>1066'</u> (material) (depth) <u>10"</u> if telescope see back: (size) (5) screen <u>35' 11"</u> <u>1068'</u> (length) (depth to top) <u>6"</u> <u>st. steel</u> (size) (material) (6) pump <u>15</u> <u>150GPM@80PSI</u> (HP) (yield gpm) <u>electric</u> (type power) (7) electric log <u>yes</u> (yes or no) <u>MS Geological Service</u> (organization running log) <u>6" BPvalve</u> (8) how well bottom plugged	clay	152	195
	sand	195	270
	sand w/stks of clay	270	439
	clay	439	595
	sandy shale	595	675
	rock	575	677
	sandy shale	677	708
	rock	708	709
	clay w/stks. of shale	709	837
	sandy shale	837	887
	rock	887	888
	clay	888	895
	sandy shale	895	933
	shale & stks. of clay	933	1015
	stks. of sand & shale	1015	1035
	clay	1035	1066
	sand w/stks. of clay	1065	1077
	sand	1077	1108
	sandy shale	1108	1116
DRILLERS REMARKS:			

CODED


DEPT. OF NATURAL RESOURCES  
 BUREAU OF LAND & WATER RESOURCES

OCT 10 1983

RECEIVED

If well telescopes please sketch and show depths.

GROUND LEVEL

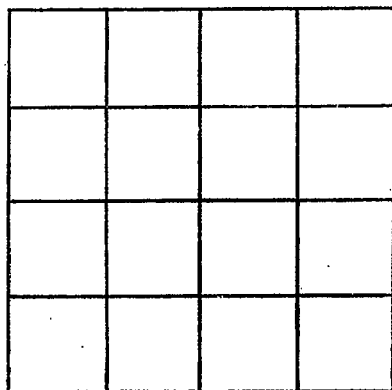

SECTION \_\_\_\_\_

Please indicate well location X.

ADDITIONAL INFORMATION

If more than one screen,  
show locations of each on sketch.