

MISSISSIPPI DEPARTMENT OF NATURAL RESOURCES

Bureau of Land and Water Resources

Southport Mall

P.O. Box 10631

Jackson, Mississippi 39209

WATER WELL DRILLERS LOG

CODED

LEFLORE  
CL-2323  
N57  
3-10-83

Elog #110

3-10 1983 Layne Central Co. Leflore  
 date well completed firm name county well located

LANDOWNER:  
Phillipston Water Assn.  
Sidon, Ms  
 (mailing address)

WELL LOCATION:  
 sec. 26 T. 18 N. R. 1 E  
3 miles W of Sidon  
 (distance) (direction) (nearest town)

WELL PURPOSE:  
 (home, irrigation, municipal, industrial)

WELL COMPLETION DATA:

(1) diameter (inches) 21"  
 (2) total depth (feet) 1108'  
 (3) static water level (feet) 20 below above top of ground.  
 (4) casing steel, 1064'  
 (material) (depth)  
10" if telescope see back.  
 (size)  
 (5) screen 35' 11", 1066'  
 (length) (depth to top)  
4", stainless steel  
 (size) (material)  
 (6) pump 15 150  
 (HP) (yield gpm)  
electric  
 (type power)  
 (7) electric log Yes  
 (yes or no)  
MS GS  
 (organization running log)  
 (8) how well bottom plugged BP Value

description of formations encountered	from to	
clay	0	17
sand	17	43
coarse sand	43	68
C. sand & pea gravel	68	82
gravel	82	152
clay	152	195
sand	195	270
sand w/ sth of clay	270	439
clay	439	595
sandy shale	595	675
rock	675	677
sandy shale	677	708
rock	708	709
clay w/ sth of shale	709	837
sandy shale	837	887
rock	887	888
clay	888	895
sandy shale	895	933
shale w/ sth of clay	933	1015
sth of sand & shale	1015	1035
clay	1035	1065
sand w/ sth of clay	1065	1077
sand	1077	1108
sandy shale	1108	1716

DEPT. OF NATURAL RESOURCES  
 BUREAU OF LAND & WATER RESOURCES


MAY 12 1983

RECEIVED

DRILLERS REMARKS:

If well telescopes please sketch and show depths.

GROUND LEVEL

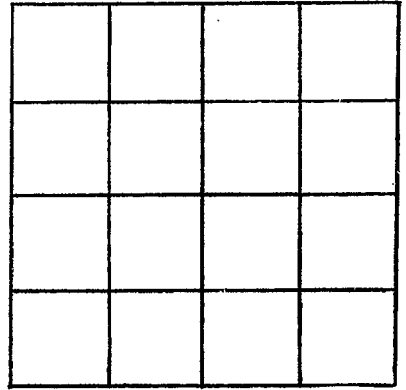

SECTION \_\_\_\_\_

Please indicate well location X.

ADDITIONAL INFORMATION

If more than one screen, show locations of each on sketch.