

MISSISSIPPI DEPARTMENT OF NATURAL RESOURCES

Bureau of Land and Water Resources

Southport Mall

P.O. Box 10631

Jackson, Mississippi 39209

CODED

WATER WELL DRILLERS LOG

LE FLORE
N 58
3/83

19 date well completed

Dyer well
firm name

DeFlora
county well located

LANDOWNER: Fred J. Peenderter

description of formations encountered

from

to

C' Layer	0	30
Sand	30	51
Sand & gravel	51	163

(mailing address)

WELL LOCATION:

sec. 21 T. 18 N. R. 1 E
S S
5 miles S of ZITTA BISSWA
(distance) (direction) (nearest town)

WELL PURPOSE:

(home, irrigation, municipal, industrial)

WELL COMPLETION DATA:

- (1) diameter (inches) 10"
- (2) total depth (feet) 103
- (3) static water level (feet) 20 below top of ground.
- (4) casing PVC, 63' (material) (depth)

CODED

(size) if telescope see back.

- (5) screen 40' (length) (depth to top)

10" PVC (size) (material)

- (6) pump 20 (HP) 1200 (yield gpm)

electric (type power)

- (7) electric log no (yes or no)

(organization running log)

- (8) how well bottom plugged Cap

DEPT. OF NATURAL RESOURCES
BUREAU OF LAND & WATER RESOURCES


MAY 9 - 1983

RECEIVED

DRILLERS REMARKS:

If well telescopes please sketch and show depths.

GROUND LEVEL

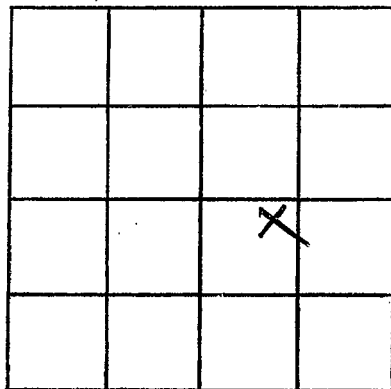

SECTION 21

Please indicate well location X.

ADDITIONAL INFORMATION

If more than one screen,
show locations of each on sketch.