

MISSISSIPPI DEPARTMENT OF NATURAL RESOURCES

Bureau of Land and Water Resources

Southport Mall

P.O. Box 10631

Jackson, Mississippi 39209

WATER WELL DRILLERS LOG

CODED

LEFLORE  
N 59  
5/16/83

May 16

19 83

Bruce Berryman

Leflore.

date well completed

firm name

Greenwood, MS

county well located

LANDOWNER: Mr. Joe Smith

Box 124. Swifttown.

MS 38959

(mailing address)

WELL LOCATION:

sec. 28 T 18 N S

R - E Morgan City

2 miles N.E. of City (distance) (direction) (nearest town)

WELL PURPOSE: Home (home, irrigation, municipal, industrial)

WELL COMPLETION DATA:

- (1) diameter (inches) 4" x 2"
- (2) total depth (feet) 160 ft.
- (3) static water level (feet) FLOW below top of ground.
- (4) casing 4" blk. gal. - 126' (material) (depth)

If telescope see back. (size)

- (5) screen 20' 1140' (length) (depth to top)

2" .010 gauge stainless steel (size) (material)

- (6) pump 1 20 (HP) (yield gpm)
- Electric (type power)

- (7) electric log NO (yes or no)
- (organization running log)

- (8) how well bottom plugged B.P.V.

DRILLERS REMARKS:

description of formations encountered

from

to

Clay	0	20
Sand	20	80
Sand & Gravel	80	160
Clay	160	180
Sand	180	480
Shale	480	600
Green sand	600	620
Shale	620	640
Sand	640	650
Shale	650	760
Shale & str. sand	760	800
Sand	800	860
Green sand & rock	860	900
Shale	900	990
Brown sand	990	1000
Shale	1000	1030
Sand	1030	1060
Shale	1060	1110
Sand	1110	1170

CODED


DEPT. OF NATURAL RESOURCES  
BUREAU OF LAND & WATER RESOURCES

DEC - 9 1983

RECEIVED

If well telescopes please sketch and show depths.

GROUND LEVEL

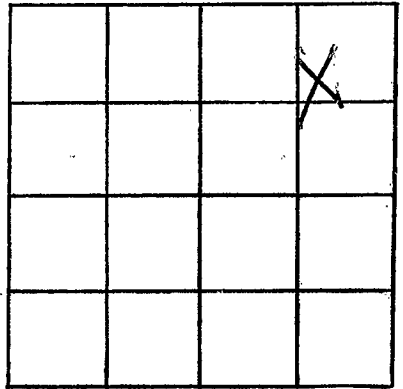

SECTION 28

Please indicate well location X.

ADDITIONAL INFORMATION

If more than one screen,  
show locations of each on sketch.