

MISSISSIPPI DEPARTMENT OF NATURAL RESOURCES

Bureau of Land and Water Resources

Southport Mall

P.O. Box 10631

Jackson, Mississippi 39209

WATER WELL DRILLERS LOG

CODED

BUTANE GAS COMPANY

OF GREENWOOD

Leflore county well located

4-9 date well completed

1984

LANDOWNER:

Angelaide Rlt.

Greenwood
(mailing address)

WELL LOCATION:

sec. 11 T. 18 N. R. 1 E. W. 3 miles SW of Grafton
(distance) (direction) (nearest town)

WELL PURPOSE:

(home, irrigation, municipal, industrial)

WELL COMPLETION DATA:

- (1) diameter (inches) 16"
- (2) total depth (feet) 115
- (3) static water level (feet) 28 below top of ground.
- (4) casing Steel 75' (material) (depth)
16" (size) if telescope see back.
- (5) screen 40' 75' (length) (depth to top)
16" (size) Steel (material)
- (6) pump 60 1100 (HP) (yield gpm)
Diesel (type power)
- (7) electric log No (yes or no)
No (organization running log)
- (8) how well bottom plugged Steel plate

description of formations encountered

from

to

CLAY 0 15

Fine SAND 15 45

sand + pre-gravel 45 98

same rock 98 100

gravel 100 115

CODED

DRILLERS REMARKS:


Richard Vot Sr.

DEPT. OF NATURAL RESOURCES
BUREAU OF LAND & WATER RESOURCES

APR 23 1984
RECEIVED

If well telescopes please
sketch and show depths.

GROUND LEVEL

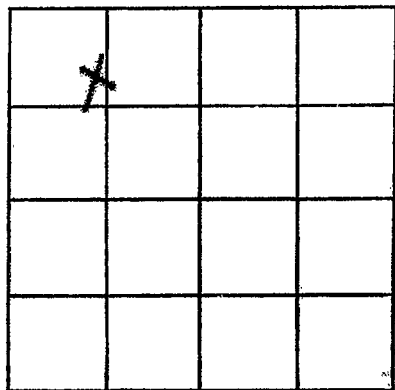

SECTION 11

Please indicate well location X.

ADDITIONAL INFORMATION

If more than one screen,
show locations of each on sketch.