

MISSISSIPPI DEPARTMENT OF NATURAL RESOURCES

Bureau of Land and Water Resources

Southport Mall

P.O. Box 10631

Jackson, Mississippi 39209

WATER WELL DRILLERS LOG

CODED

N 61
 Letlore Co.
 4-13-84

4-13
 date well completed

19

84

BUTANE GAS COMPANY

firm name

OF GREENWOOD

Letlore
 county well located

LANDOWNER:

Myrtle side Plantation

Greenwood
 (mailing address)

description of formations encountered

from

to

Clay

0

15

sand

15

65

gravel

65

105

WELL LOCATION:

sec. 11 T. 18 N. R. 1 E.

2.5 miles S.W. of Quita
 (distance) (direction) (nearest town)

CODED

WELL PURPOSE:

(home, irrigation, municipal, industrial)

WELL COMPLETION DATA:

- (1) diameter (inches) 16"
- (2) total depth (feet) 105
- (3) static water level (feet) 19 ^{below} above top of ground.

- (4) casing steel 65'
 (material) (depth)
 16" if telescope see back.
 (size)

- (5) screen 40' 65'
 (length) (depth to top)

- 16" steel
 (size) (material)

- (6) pump 60 1100
 (HP) (yield gpm)

Diase
 (type power)

- (7) electric log No
 (yes or no)

No
 (organization running log)

- (8) how well bottom plugged Steel plate

DRILLERS REMARKS:

Richard Vert M.


DEPT. OF NATURAL RESOURCES
 BUREAU OF LAND & WATER RESOURCES

APR 23 1984

RECEIVED

If well telescopes please sketch and show depths.

GROUND LEVEL

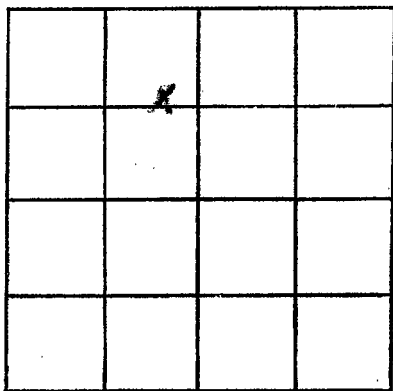

SECTION 11

Please indicate well location X.

ADDITIONAL INFORMATION

If more than one screen,
show locations of each on sketch.