

MISSISSIPPI DEPARTMENT OF NATURAL RESOURCES

Bureau of Land and Water Resources

Southport Mall

P.O. Box 10631

CODED

Jackson, Mississippi 39209

WATER WELL DRILLERS LOG

LEFLORE  
N 62  
5-25-84

5/25/84 19 Deer Well LeFlore  
date well completed firm name county well located

LANDOWNER:	description of formations encountered	from	to
<u>J. Joe Thomas</u>			
<u>Croger, Miss.</u> (mailing address)	<u>Clay</u>	<u>0</u>	<u>28</u>
	<u>Hard Sand</u>	<u>28</u>	<u>58</u>
	<u>Sand</u>	<u>58</u>	<u>68</u>
	<u>Sand &amp; Gravel</u>	<u>68</u>	<u>178</u>
WELL LOCATION: sec. <u>17</u> T. <u>17</u> R. <u>1</u> <u>4</u> miles <u>SW</u> of <u>Sidan</u> (distance) (direction) (nearest town)			
WELL PURPOSE: <u>ing.</u> (home, irrigation, municipal, industrial)			
WELL COMPLETION DATA:			
(1) diameter (inches) <u>16</u>			
(2) total depth (feet) <u>108</u>			
(3) static water level (feet) <u>26</u> below top of ground.			
(4) casing <u>STEEL</u> <u>68'</u> (material) (depth)			
<u>16</u> if telescope see back. (size)			
(5) screen <u>60"</u> <u>68'</u> (length) (depth to top)			
<u>16</u> <u>STEEL</u> (size) (material)			
(6) pump <u>60</u> <u>3000</u> (HP) (yield gpm)			
<u>Dies</u> (type power)			
(7) electric log <u>No</u> (yes or no) <u>No</u> (organization running log)			
(8) how well bottom plugged <u>STEEL PLATE</u>			
DRILLERS REMARKS:			

CODED


DEPT. OF NATURAL RESOURCES  
BUREAU OF LAND & WATER RESOURCES

MAY - 2 1984

RECEIVED

If well telescopes please sketch and show depths.

GROUND LEVEL

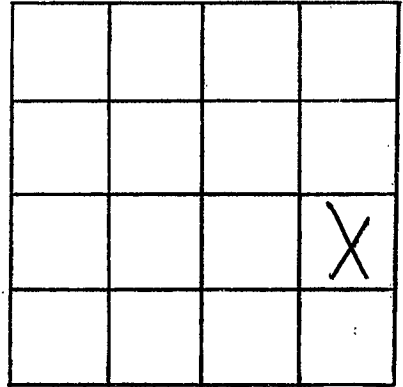

SECTION 1

Please indicate well location X.

ADDITIONAL INFORMATION

If more than one screen, show locations of each on sketch.