

MISSISSIPPI DEPARTMENT OF NATURAL RESOURCES

Bureau of Land and Water Resources

Southport Mall

P.O. Box 10631

Jackson, Mississippi 39209

WATER WELL DRILLERS LOG

CODED

LEFLORE  
N 63  
5-23-84

5/23/84  
date well completed

19 Dyer Well  
firm name

Leflore  
county well located

LANDOWNER:

J. Tol Thomas

description of formations encountered

from

to

Crozier, Miss.  
(mailing address)

Clay 0 35  
Fine Sand 35 68  
Sand & Gravel 68 108

WELL LOCATION:

sec. 36 T 18 N R 1 E  
4 miles S.W. of Sidon  
(distance) (direction) (nearest town)

CODED

WELL PURPOSE:

Irrig.  
(home, irrigation, municipal, industrial)

WELL COMPLETION DATA:

- (1) diameter (inches) 16
- (2) total depth (feet) 108'
- (3) static water level (feet) 26' below above top of ground.
- (4) casing STEEL, 68',  
(material) (depth)  
16 if telescope see back.  
(size)
- (5) screen 40, 68'  
(length) (depth to top)  
16, STEEL  
(size) (material)
- (6) pump 1/2 3000  
(HP) (yield gpm)  
DIES  
(type power)
- (7) electric log No  
(yes or no)  
No  
(organization running log)

(8) how well bottom plugged  
STEEL PLATE

DRILLERS REMARKS:


DEPT. OF NATURAL RESOURCES  
BUREAU OF LAND & WATER RESOURCES

JUL - 2 1984

RECEIVED

If well telescopes please sketch and show depths.

GROUND LEVEL

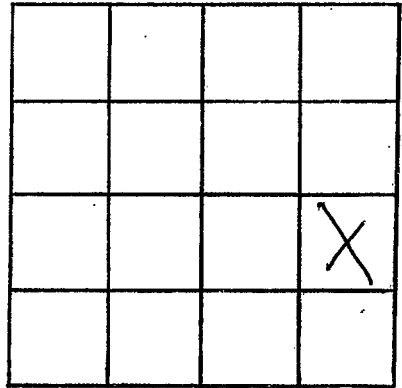

SECTION 36

Please indicate well location X.

ADDITIONAL INFORMATION

If more than one screen, show locations of each on sketch.