

MISSISSIPPI DEPARTMENT OF NATURAL RESOURCES

Bureau of Land and Water Resources

Southport Mall

P.O. Box 10631

Jackson, Mississippi 39209

WATER WELL DRILLERS LOG

CODED

LEFLORE  
86128KSE-02  
N 66

May 16, 1986 date well completed  
DYER WELL, Inc. firm name  
Leflore county well located

LANDOWNER: Mr. Jack Williams

description of formations encountered

Morgan City, Miss.  
(mailing address)

description of formations encountered	from	to
Clay	7	20
Hard Sand	20	28
Sand & Gravel	28	35
Sand & Gravel	35	100


WELL LOCATION:  
sec. 31 T. 18 N. R. 1 E. S. 9 N 66 W  
1/2 miles N.W. of Morgan City  
(distance) (direction) (nearest town)

CODED

WELL PURPOSE: Irrigation  
(home, irrigation, municipal, industrial)

WELL COMPLETION DATA:

- (1) diameter (inches) 16
- (2) total depth (feet)
- (3) static water level (feet) below top of ground.
- (4) casing Steel (material), (depth) 16" (size) if telescope see back.
- (5) screen 40 (length), (depth to top) 16" (size), Mild Steel (material)
- (6) pump 100 (HP) 1600 (yield gpm) Diesel (type power)
- (7) electric log No. (yes or no) (organization running log)
- (8) how well bottom plugged Photo

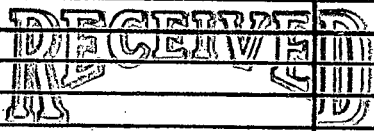

SEP 19 1986


Department of Natural Resources  
Bureau of Land & Water Resources

DRILLERS REMARKS:

86128KSE-02

If well telescopes please sketch and show depths.

GROUND LEVEL

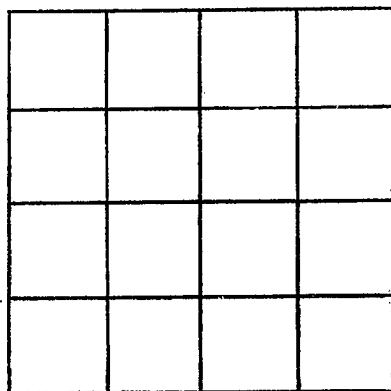

SECTION \_\_\_\_\_

Please indicate well location X.

ADDITIONAL INFORMATION

If more than one screen,  
show locations of each on sketch.