

LEFLORE  
N 67

MISSISSIPPI DEPARTMENT OF NATURAL RESOURCES  
 Bureau of Land and Water Resources  
 Southport Mall  
 P.O. Box 10631  
 Jackson, Mississippi 39209  
**WATER WELL DRILLERS LOG**

**CODED**

7-85 19 Cook Drilling Co L. Flare  
 date well completed firm name county well located

**LANDOWNER:**  
Hooker Farmer  
Greenwood Drive  
Sider (mailing address)

description of formations encountered	from	to
<u>Sandy Clay</u>	<u>Top</u>	<u>20'</u>
<u>Hard Sand</u>	<u>20'</u>	<u>60'</u>
<u>Sand &amp; gravel</u>	<u>60'</u>	<u>110'</u>

**WELL LOCATION:**  
 sec 36 T 72 N R 1 E  
2 miles South E. of Sider  
 (distance) (direction) (nearest town)

**WELL PURPOSE:**  
 (home, irrigation, municipal, industrial)

**WELL COMPLETION DATA:**

- (1) diameter (inches) 10"
- (2) total depth (feet) 110'
- (3) static water level (feet) 25' below top of ground.
- (4) casing Steel, 70'  
 (material) (depth)  
10" if telescope see back.  
 (size)
- (5) screen 10", 70'  
 (length) (depth to top)  
10', Steel  
 (size) (material)
- (6) pump 40, 600  
 (HP) (yield gpm)  
perusal  
 (type power)
- (7) electric log \_\_\_\_\_  
 (yes or no)  
 \_\_\_\_\_  
 (organization running log)
- (8) how well bottom plugged \_\_\_\_\_

**CODED**

**RECEIVED**


SEP 29 1985

Department of Natural Resources  
 Bureau of Land & Water Resources

**DRILLERS REMARKS:**

If well telescopes please sketch and show depths.

GROUND LEVEL

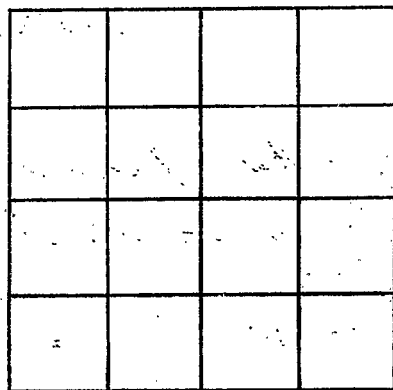

SECTION \_\_\_\_\_

Please indicate well location X:

ADDITIONAL INFORMATION

If more than one screen,  
show locations of each on sketch.