

MISSISSIPPI DEPARTMENT OF NATURAL RESOURCES

Bureau of Land and Water Resources

Southport Mall

P.O. Box 10631

Jackson, Mississippi 39209

WATER WELL DRILLERS LOG

LEFLORE
N 68

1-2 1987 J B K THIGATTON LEFLORE  
 date well completed firm name county well located

LANDOWNER: DON SHORTS  
GREENWOOD, MISS  
 (mailing address)


description of formations encountered	from	to
TOP SOIL	0	81
CLAY	8	19
FINE SAND	19	42
COARSE SAND & GRAVEL	42	111

WELL LOCATION:  
 sec. 31 T. 18 N. R. 1 W.  
1 miles E of MORGAN CITY  
 (distance) (direction) (nearest town)

WELL PURPOSE: IRRIGATION  
 (home, irrigation, municipal, industrial)

WELL COMPLETION DATA:

- (1) diameter (inches) 8"
- (2) total depth (feet) 116
- (3) static water level (feet) 21 ~~above~~ below top of ground.
- (4) casing POC 76  
 (material) (depth)  
8" if telescope see back.  
 (size)
- (5) screen 40 76  
 (length) (depth to top)  
8" POC  
 (size) (material)
- (6) pump 10 600  
 (HP) (yield gpm)  
Electric  
 (type power)
- (7) electric log NO  
 (yes or no)  
 (organization running log)
- (8) how well bottom plugged CAP

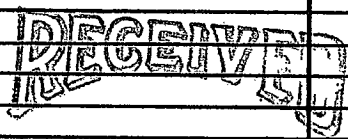


JAN 27 1987

Department of Natural Resources  
 Bureau of Land & Water Resources

DRILLERS REMARKS:

If well telescopes please sketch and show depths.

GROUND LEVEL

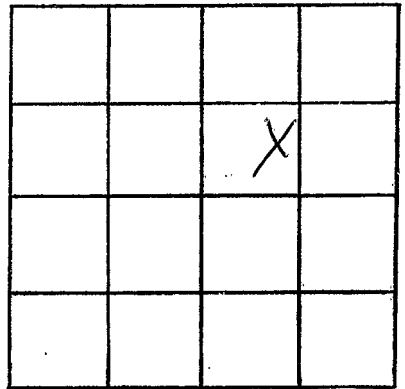

SECTION 31

Please indicate well location X.

ADDITIONAL INFORMATION

If more than one screen,  
show locations of each on sketch.