

MISSISSIPPI DEPARTMENT OF NATURAL RESOURCES

Bureau of Land and Water Resources

Southport Mall

P.O. Box 10631

Jackson, Mississippi 39209

WATER WELL DRILLERS LOG

CODED

LEFLORE
N 69

May 21 19 86 Bruce Berryman Leflore
date well completed firm name county well located

LANDOWNER:	description of formations encountered	from	to
Mr. Jack Williams.	Clay	0	40
P.O. Drawer G.	Sand	40	60
Morgan City.	Sand & Gravel	60	120
MS 38946	Clay	120	140
(mailing address)	Sand	140	180
WELL LOCATION:	Clay	180	280
sec. 31 T. 18 N R. E	Sand Str. Clay	280	360
S 1 W	Fine sand	360	500
1/4 miles north of Morgan City	Shale	500	640
(distance) (direction) (nearest town)	Green sand & hard rock & str. shale	640	700
WELL PURPOSE: HOME	Green sand	700	740
(home, irrigation, municipal, industrial)	Grn. sand & str shale	740	800
WELL COMPLETION DATA:	Sand & str. shale	800	860
(1) diameter (inches) 4" x 2"	Shale	860	900
(2) total depth (feet) 1210'	Shale & str. sand	900	1000
(3) static water level (feet) FLOW below top of ground. - 126'	Fine brown sand	1000	1020
(4) casing 2" gal. 1064' (material) (depth)	Clay	1020	1030
(size) If telescope see back.	Fine sand	1030	1140
(5) screen 20' 1190' (length) (depth to top)	Sand	1140	1229
2" .010 ga. Stainless steel (size) (material)			
(6) pump 1 h.p. 19 (HP) (yield gpm)			
Electric (type power)			
(7) electric log NO (yes or no)			
(organization running log)			
(8) how well bottom plugged B.P.V.			
DRILLERS REMARKS:			

CODED


RECEIVED

MAR 18 1987

Department of Natural Resources
Bureau of Land & Water Resources

If well telescopes please sketch and show depths.

GROUND LEVEL

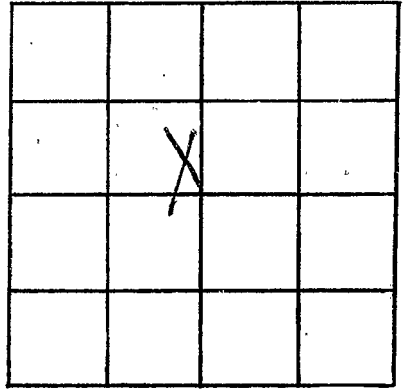

SECTION 31

Please indicate well location X.

ADDITIONAL INFORMATION

Lined area for additional information.

If more than one screen, show locations of each on sketch.