

LETLORE  
N70

MISSISSIPPI DEPARTMENT OF NATURAL RESOURCES

Bureau of Land and Water Resources **CODED**

Southport Mall

P.O. Box 10631

Jackson, Mississippi 39209

WATER WELL DRILLERS LOG

5-3

1987 BUTANE GAS CO. OF GREENWOOD

Letlore

date well completed


firm name

county well located

LANDOWNER:	description of formations encountered	from	to
W.P. Kimbrough & Son	CLAY	0	25
Itha Ben A (mailing address)	FINE SAND	25	60
WELL LOCATION:	SAND + PEA GRAVEL	60	85
sec. 9 T 18 N R 1 E 3/4 miles S/E of Quito (distance) (direction) (nearest town)	GRAVEL	85	105
WELL PURPOSE: <u>IRRIGATION</u> (home, irrigation, municipal, industrial)	<b>CODED</b>		
WELL COMPLETION DATA:			
(1) diameter (inches) <u>16"</u>			
(2) total depth (feet) <u>105'</u>			
(3) static water level (feet) <u>25'</u> below above top of ground.			
(4) casing <u>Steel</u> , <u>16'</u> (material) (depth) <u>16"</u> if telescope see back. (size)			
(5) screen <u>40'</u> , <u>65'</u> (length) (depth to top) <u>16"</u> , <u>Steel</u> (size) (material)			
(6) pump <u>40</u> <u>2000</u> (HP) (yield gpm) <u>Diesel</u> (type power)	<b>RECEIVED</b>		
(7) electric log <u>NO</u> (yes or no)  (organization running log)	JUN 03 1987		
(8) how well bottom plugged <u>Steel Plate</u>	Department of Natural Resources Bureau of Land & Water Resources		
DRILLERS REMARKS:			

If well telescopes please sketch and show depths.

GROUND LEVEL

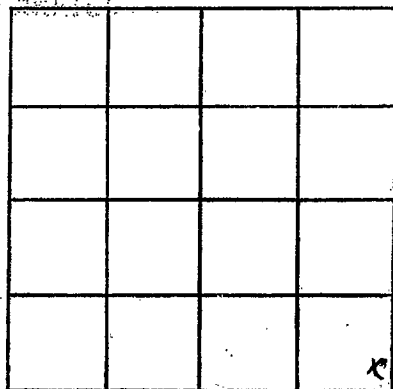

SECTION \_\_\_\_\_

Please indicate well location X.

ADDITIONAL INFORMATION

If more than one screen, show locations of each on sketch.