

MISSISSIPPI DEPARTMENT OF NATURAL RESOURCES

Bureau of Land and Water Resources

Southport Mall

P.O. Box 10631

Jackson, Mississippi 39209

WATER WELL DRILLERS LOG

LeFlore
N 71
148 D

Coded

~~4-12~~ 4-12 1987 J&K Irrigation LeFlore
 date well completed firm name county well located

LANDOWNER: W. H. Motz, Jr
906 Weightman
Greenwood, Miss 38930
 (mailing address)

description of formations encountered	from	to
CLAY	0	21
fine sand	21	41
Coarse sand & gravel	41	115

WELL LOCATION:
 sec. 7 T. 17 N. R. 1 E
3 miles SE of MORAN CITY
 (distance) (direction) (nearest town)

WELL PURPOSE: IRRIGATION
 (home, irrigation, municipal, industrial)

WELL COMPLETION DATA:

(1) diameter (inches) 16"

(2) total depth (feet) 115

(3) static water level (feet) 21 below top of ground.

(4) casing Steel 985
 (material) (depth)
16" if telescope see back.
 (size)

(5) screen 40' 85
 (length) (depth to top)
16" Steel
 (size) (material)

(6) pump 50 2400
 (HP) (yield gpm)
Diesel
 (type power)

(7) electric log NO
 (yes or no)
 (organization running log)

(8) how well bottom plugged PIATE

RECEIVED


NOV 12 1987

Department of Natural Resources
 Bureau of Land & Water Resources

DRILLERS REMARKS:

If well telescopes please sketch and show depths.

GROUND LEVEL

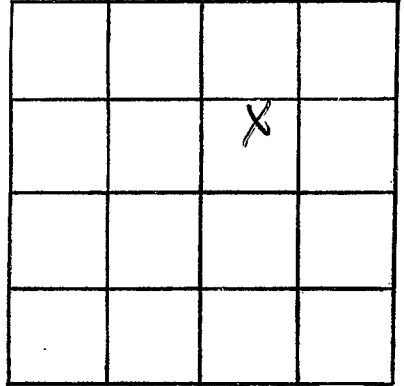

SECTION 2

Please indicate well location X.

ADDITIONAL INFORMATION

If more than one screen,
show locations of each on sketch.