

MISSISSIPPI DEPARTMENT OF NATURAL RESOURCES

Bureau of Land and Water Resources

12844

COUNTY WELL LOCATED
Leflore

WELL NUMBER
N 75

CODED

DATE WELL COMPLETED
3-24-90

PERMIT NUMBER
MS GW ~~12463~~

NAME OF DRILLING FIRM
Dyan Well

P.O. Box 10631
Jackson, Mississippi 39209
WATER WELL DRILLERS LOG

CODED

NAME & MAILING ADDRESS OF LANDOWNER
W. P. Kimbrough & Son
Rt 1 Box 22A
ITHA Bena Ms 38941

WELL LOCATION: SEC **27** TOWNSHIP **18** RANGE **1**

DISTANCE _____ MILES _____ OF _____ NEAREST TOWN

OTHER LANDMARK _____

WELL PURPOSE: Home Irrigation, Municipal, Industrial, Fish Pond, etc.

PUMP DATA

PUMP TYPE (Circle One):
Submersible, Turbine, Jet, Flowing Well,
Other (Describe) _____

POWER TYPE (Circle One):
Electric, Tractor, Diesel, Gasoline, Butane,
Other (Describe) _____ H/P _____

Pump Capacity (GPM) **1500** No. of Stages **2** Setting Depth **60** FT.

PUMP TEST

Well yielded _____ GPM with
a drawdown of _____ ft.
after _____ hours of pumping

WELL DATA

Well Depth 104'	Casing Diameter (In.) 16"	Casing Length (Ft.) 64'
Type of Casing steel	Hole Depth	Depth to Static Water Level

TYPE OF COMPLETION: (Circle One or More):
Gravel Packed, Underreamed, Telescoped,
Natural Development, Open Hole, Other
(Describe) _____

Top of Lap Pipe or Reduction in Casing

FEET IF TELESCOPED OR MORE THAN ONE SCREEN: USE BACK PAGE

LOG DATA

TYPE OF LOG RUN (Circle One):
Electric, Gamma Ray, Density, Sonic, Neutron,
Other (Describe) No Log Run

Name of Organization Running Log
None

SCREEN DATA

Diameter - Inches 16"	Length - Feet 40'	Slot Size - Inches .030
Screen Type Wire Wrap	Depth to Bottom - Feet	

GEOLOGIC DATA (Office Use Only)

Surface Elev.	Geologic Unit	Unit Thickness	Depth to Top
Subs. SWL	Date	Analysis	Aquifer Test

Driller's Remarks

DESCRIPTION OF FORMATIONS ENCOUNTERED	FROM	TO
Clay	0	26
Fine Sand	26	40
Fine Sand + Gravel	40	70
Sand + Gravel	70	80
Fine Sand + Gravel	80	94
Sand + Gravel	94	104

FORMATIONS (Continued)

REGISTERED


JUL 02 1990

Department of Natural Resources
Bureau of Land & Water Resources

IF MORE SPACE IS NEEDED, USE BACK

If well telescopes please
sketch and show depths.

GROUND LEVEL

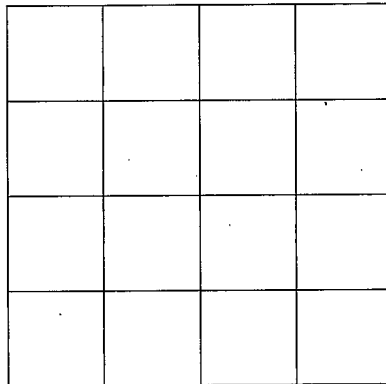

SECTION _____

Please indicate well location X.

ADDITIONAL INFORMATION

If more than one screen,
show location of each on sketch.