DAVID. Hodges

A. A	7	State We	ll Report	For Office Use Only:			
1		Dar	+ 1	Aquifer:			
y: LE	FLORE	Mississippi Department	of Environmental Quality				
amit #:	42483	Office of Land and	Water Resources x 10631	Well #:			
Deller J.	NEWCOME 0-773	Jackson, MS	39289-0631	L S. Elevation:			
Date drilling	completed: 4-08-08	1 (601)9	61-5210 -6938 (fax)	E-log #:			
		7		with the Department within			
State Law requires that this report be prepared by the driller in detail and filed with the Department within							
20 days of completific to thinking of the same of the							
	Well Owner Inform	nation	33.25	28" Longitude: 050 20 . 54"			
Owner Nan	KEAR CRE	Krarmine	Latitude:	OS" Longitude: OS · 20 · 54" one): Conventional Survey.			
36 77 4	Idress Mo Daulo	HODGES	Welling of Pan Forte (organ				
Mailing At	J01633.		USGS quad, Hand-h	eld GPS Survey-grade GPS			
	1111 0	UT ROADZ 80	NWW SW 4 Sec_	8 Twn 18N Rng IW			
	Cirt Con	State MSZIPSOSCO41	Direction	n Nearest Town			
	(1)	7857	Distance Direction Miles SW	of ITTA BEHA			
Telephone	t comply yours		Data				
Purnose	of Well (circle one) Home	Industrial Public Supply	Irrigation Fish Culture				
Turpose	4-0	8-08 Date	well drilling completed:	4-08-08			
Date wel	I drilling starten:	Oubse	(describe)				
If flowin	g, method of flow regulation:	ValveOther	(ucacriate)	red.			
Static W	fater Level:fe	cet above or below (circle one	e) land surface Date measu				
Method	of Measurement (circle one)	steel tape electric ta	pe air line other: _				
Hole de	pth: 112 w	ell depth:[()	Well grouted to a depti	n offeet			
l l		\sim \sim \sim	ix				
1	grout (circle one): Cemen	Casing diameter: 16	inches Type of casi	ing: Poc			
Casing	length: 70 feet	Casing diameter:		en: Puc			
Screen	length: 40 feet	Screen diameter:		1 1 1			
1_	050 in	sches Setting depth: Fro	m 70 feet to				
Турсо	of completion (circle all applie	cable): Gravel packed U	nderreamed Telescoped	Open hole Natural Development			
	· .	Other (describe):					
_	Top of lap pipe or reduction in casing:feet. If telescoped or more than one screen, describe on back of page						
Top of	t tab bibe of tenuenou in cast						
Logs	run (circle all applicable) No	o log rum Electric Gamma	Ray Density Some Tree				
Name	of organization running log(s):	d in accordance with all app	licable requirements of the Mississippi.			
I cert	tify that the well was drilled	, constructed, and complete uality and/or the Mississipp	I Dengriment of Health reg	ulations and state laws.			
Depa	artment of Environmental Q	uality and/or the Mississipp	1 N	· > nearlyti			
-	OHN NEWCOME C)-773	Jol-	- LOWCHIE EIVE			
L ——		otor and License No.	Sig	nature of Water Well Contractor			
Prin	t Name of Water Well Contra	CIOI AND LICENSO LIG.		. MAY 1 A 2008			

MAY 1 4 2008

YMD JOINT WATER
MANAGEMENT DISTRICT

State Well Report						
County LE FLORE Part 1						
Mississippi Department of Environmental Quality Aquifer:	-					
	_					
Driller: J. NEW USAE J. J. S. Playetion:						
Date drilling completed: 4-08-08 (601)961-5210						
(601)354-6938 (fax) E-log #:						
State Law requires that this report be prepared by the driller in detail and filed with the Department within 30 days of completion of drilling of the well.						
Well Owner Information Well Location						
Owner Name Ear CREKFARM The Latitude: 33. 25. 08" Longitude: 090. 20. 54	',, -					
Mailing Address Oo David Hoogs Method of Lat/Long (circle one): Conventional Survey,						
USGS quad, Hand-held GPS Survey-grade GPS						
116 Court Road 80 NW4 SW4 Sec 18 Twn 18N Rng W	-					
Telephone Neft (2) - 254 - 7857 Distance Direction Nearest Town 5 Miles SW of ITTA BENA						
1 elephone Me((b)) = 23 4 - 783 7 Miles 3W of 211-182-18						
Well Data						
Purpose of Well (circle one) Home Industrial Public Supply Irrigation Fish Culture Other:						
Date well drilling started: 4-08-08 Date well drilling completed: 4-08-08						
If flowing, method of flow regulation: Valve Other (describe)						
Static Water Level:feet above or below (circle one) land surface Date measured:						
Method of Measurement (circle one) steel tape electric tape air line other:						
Hole depth: 112 Well depth: 110 Well grouted to a depth of 10 feet						
Type of grout (circle one): Cement Bentonite Mix						
Casing length: 70 feet Casing diameter: 16 inches Type of casing: Poc						
Screen length: 40 feet Screen diameter: 16 inches Type of screen: Poc						
Screen slot size:						
Type of completion (circle all applicable): Gravel packed Underreamed Telescoped Open hole Natural Development						
13/fe of completion (check an applicable). Of aver packers of other reactions of the check and applicable).	Other (describe):					
Other (describe):						
Other (describe): Top of lap pipe or reduction in casing:feet. If telescoped or more than one screen, describe on back of page Logs run (circle all applicable): No log run Electric Gamma Ray Density Sonic Neutron Other: Name of organization running log(s):	-					
Other (describe): Top of lap pipe or reduction in casing:	-					

Print Name of Water Well Contractor and License No.

Signature of Water Well Contractor
RECEIVED
MAY 0 9 2008
BY: OLWR


If well telescopes please sketch below and show depths.

Ground Level	

	casing
	70'
Scieen	
_	-110

Description of Formations Encountered	From	То
Top Soil	0	10
Fine sand	10	70
COArse Sand · Grand Rodu	70	1
COMIC SAME GALLE COLO	10	114
	l	
		
	 	
	ļ	\vdash
		

If more than one screen, show location of each on sketch

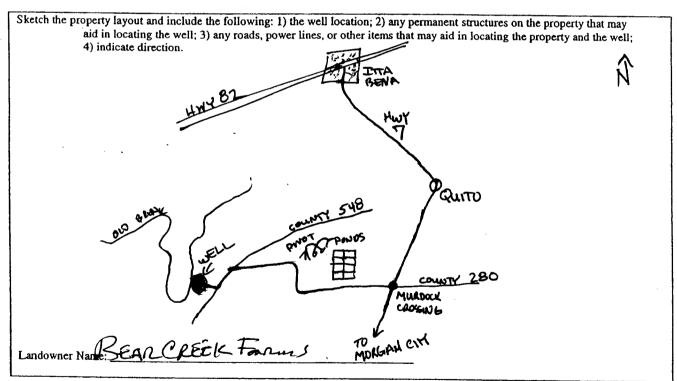

Signature of Water Well Contractor

STATE WELL REPORT

	rt 2 Completion Report For Office Use Only:
C(1)(1)(1)(1)(1) Mississippi Department	of Environmental Quality d Water Resources Aquifer:
P.O. B	ox 10631 S 39289-0631 Well #: 12/
Date completed: $4-08-08$ (601)9	
This report should be prepared by the pump installer in detail installation of pump.	and filed with the Department within 30 days of the
Well Owner Information	" Well Location
Owner Nam BEAR CREEK FARMS INC	Latitud 33-25-08 Longitud 390-20-54
Mailing Addres Co Daviothoras	Method of Lat/Long (circle one): Conventional Survey,
1/16 COUNTY KOAD 280	,
ITTA BEND, MS. 38941 City State Zip Code	NW1/4 Sw 1/4 Sec / 8 Twn/&N Rng W
City State Zip Code	Distance Direction Nearest Town
Telephone NGCZ1254 7877	5 Miles W of ITTARENA
Pump Type	Power Type
Circle one	Circle one
Air Lift Jet Submersible	Diesel Engine Gasoline Engine Natural Gas
Bucket Piston Turbine	Electric Motor Hand Tractor PTO
Centrifugal Rotary Flowing Well	Windmill Other (specify):
Other (specify):	Horse Power Rating of Motor:
Date Pump Installed: 4-20-08	Setting Depth: 600 feet
Rated Pump Capacity: Scoo Gallons Per Minute	Setting Depth: 600 feet Number of Stages: PECEIVED
Pump Test Data	Mathad of Managina Water Lawking Og 2005
Date Well Tested:	Method of Measuring Water Level AV 09 2000 Circle one Air Line Electric Measuring Line Bell Tape
Static Water Level (A):Feet Below Land Surface	Air Line Electric Measuring Line Gel Tape
Pumpin Water Level (B) Feet Below Land Surface	Other (specify):
Drawdown [(B) - (A)]:Feet Below Land Surface	For flowing well, measured shut in head:feet
Test Pumping Rate:Gallons Per Minute ~	Well yieldedGPM with a drawdown of
Duration of Pump Test (minimum 4 hours):hours	feet afterhours of pumping
I HEREBY CERTIFY that the above statements are true to the best of	of my knowledge
GLEN Cours 7/08	1 mour
Print Name of Pump Installer and License No. (if applicable)	Signature of Pump Installer

. State W	ell Report For Office Use Only:					
	art 1					
Mississippi Departmen	t of Environmental Quality Aquite:					
(Trimetion Formant)	Box 10631 Well #:					
lackson N	IS 39289-0631 L.S. Elevation:					
- · · · · · · · · · · · · · · · · · · ·	961-5210					
(601)35	4-6938 (fax) E-log 4:					
State Law requires that finds report be prepared by the driller in detail and filed with the Department within 30 days of completion of drilling of the well.						
Well Owner Information	Well Location					
Owner Name Feat and Company	Latitude: 33 · 33 · 36.7 Longitude: 90 · 05 · 57 76					
Mailing Address: 991 County Rd 188	Method of Let Long (circle one): Conventional Survey,					
	USGS quad, Hand-held GPS, Survey-grade GPS					
Greenwayd Ms. 38930 City State Zip Code	NE 1/4 SE 1/4 Sec 29 Twn 20N Rug 2E					
City State Zip Code Telephone No. 662, 453 - 8319	Distance Direction Negrest Town 4. Miles NE of Greenwood					
771 310						
Well I						
Purpose of Well (circle one) Home Industrial Public Supply Inigation Fish Culture Other Replacement Date well drilling started: 8-2-07 Gu 2011						
If flowing, method of flow regulation: Valve Other (de	cscribe)					
Static Water Level: 14 feet above of below (circle one) land surface Date measured: 8-3-07						
Method of Measurement (circle one) (steel tape) electric tape air line office.						
Hole depth: 97 Well depth: 97 Well grouted to a depth of 10 feet						
Type of grout (circle one): Coment Bentonite Mix						
Casing length: 60 feet Casing diameter /6	inches Type of easing: PVC					
Screen length: 37 feet Screen diameter: 16 inches Type of screen: PVC						
Screen slot size: • 050 inches Setting depth: From	See back feet to					
Type of completion (circle all applicable): Gravel packed Under	reamed Telescoped Open holo Natural Deschapment					
Other (describe):	HECEIVED					
Top of lap pipe or reduction in easing: feet. If tel	escoped or more firm one screen, describe on back of page					
Logs run (circle all applicable). No log run Electric Gamma Ray Density Sonic Neutron Other.						
Plame of organization running log(s): 1 certify that the well was drilled, constructed, and completed in accordance with all applicable regarded. The Wisselff H. CT						
Department of Environmental Quality and/or the Mississippi Dep						
Irrigation Equipment Inc.	721					
Patrick M. Chism 0695						
Print Name of Water Well Contractor and License No.	Signature of Water Well Contractor					
42103						